


Give All Information Completely
Make Required Affidavit
Mail or Deliver Report to:
Conservation Division
State Corporation Commission
211 No. Broadway
Wichita, Kansas

WELL PLUGGING RECORD

NORTH

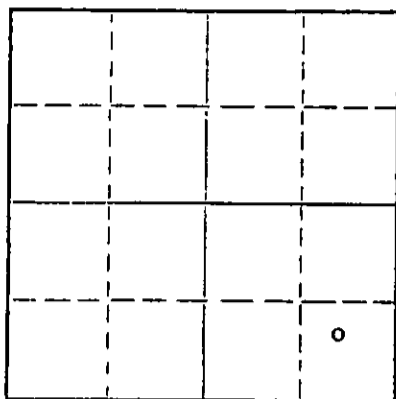

Locate well correctly on above
Section Plat

Ness County. Sec. 28 Twp. 18S Rge. 24W (E) (W)
Location as "NE/CNW/SW" or footage from lines c SE SE
Lease Owner Palomino Petroleum
Lease Name Cranston Well No. 1
Office Address 304 Insurance Bldg., Wichita, Kansas 67202
Character of Well (completed as Oil, Gas or Dry Hole) Dry Hole
Date well completed July 5 19 70
Application for plugging filed July 5 19 70
Application for plugging approved July 5 19 70
Plugging commenced July 5 19 70
Plugging completed July 5 19 70
Reason for abandonment of well or producing formation Dry Hole

If a producing well is abandoned, date of last production _____ 19____
Was permission obtained from the Conservation Division or its agents before plugging was commenced? Yes

Name of Conservation Agent who supervised plugging of this well W. L. Nichols
Producing formation _____ Depth to top _____ Bottom _____ Total Depth of Well 4345 Feet
Show depth and thickness of all water, oil and gas formations.

OIL, GAS OR WATER RECORDS

CASING RECORD

FORMATION	CONTENT	FROM	TO	SIZE	PUT IN	PULLED OUT
		0	240'	8 5/8"	240'	None

Describe in detail the manner in which the well was plugged, indicating where the mud fluid was placed and the method or methods used in introducing it into the hole. If cement or other plugs were used, state the character of same and depth placed, from _____ feet to _____ feet for each plug set.

Plug: 600'/70 sacks cement
220'/20 sacks cement
40'/10 sacks cement & 1/2 sack hulls

RECEIVED
STATE CORPORATION COMMISSION
JUL 15 1970
CONSERVATION DIVISION
Wichita, Kansas

(If additional description is necessary, use BACK of this sheet)
Name of Plugging Contractor Hellar Drilling Company, Inc.
Address 339 Union Center Bldg., Wichita, Kansas 67202

STATE OF Kansas, COUNTY OF Sedgwick, ss.
D. L. Hellar, President of Hellar Drlg. Co. (Employee of owner) or (owner or operator) of the above-described well, being first duly sworn on oath, says: That I have knowledge of the facts, statements, and matters herein contained and the log of the above-described well as filed and that the same are true and correct. So help me God.

(Signature) D. L. Hellar D. L. Hellar, President
339 Union Center Bldg., Wichita, Kansas 67202
(Address)



Subscribed and sworn to before me this 14th day of July, 19 70
My commission expires March 25, 1972
Catherine Darcey
Notary Public.

15-135-20350-0000

DRILLER'S LOG

COMPANY: Palomino Petroleum, 304 Insurance Bldg., Wichita, Kansas 67202
 CONTRACTOR: Hellar Drilling Company, Inc., Wichita, Kansas 67202
 LEASE: #1 Cranston
 LOCATION: c SE SE 28-18S-24W, Ness County, Kansas
 COMMENCED: June 23, 1970
 COMPLETED: July 5, 1970
 CASING: Set 8 5/8" Surface Casing @ 240'/175 sacks cement

0-60	Surface soil & Shale
60-243	Shale
243-770	Shale-Chalk
770-1048	Shale - Red Bed
1048-1278	Sand
1278-1478	Red Bed & Shale
1478-1578	Shale
1578-1623	Anhydrite
1623-1840	Shale & Shells
1840-2235	Salt Section & Lime & Shale
2235-2978	Lime & Shale
2978-3125	Shale & Lime
3125-3510	Lime & Shale
3510-3590	Lime
3590-3730	Lime & Shale
3730-3765	Lime
3765-3795	Lime (L. K. C.)
3795-4047	Lime
4047-4260	Lime & Shale
4260-4270	Lime (Ft. Scott)
4270-4345	Lime (Cherokee Sand & Miss.)
4345	Rotary Total Depth

RECEIVED
 STATE CORPORATION COMMISSION
 JUL 15 1970
 CONSERVATION DIVISION
 Wichita, Kansas

D & A

STATE OF KANSAS)
) SS
 COUNTY OF SEDGWICK)

I, D. L. Hellar, do hereby certify that the above and foregoing is a true and correct copy of the log of the #1 Cranston, located in c SE SE 28-18S-24W, Ness County, Kansas as reflected by the files of the Hellar Drilling Company, Inc.

HELLAR DRILLING COMPANY, INC.

By *D. L. Hellar*
 President - D. L. Hellar



Subscribed and sworn to before me, a Notary Public, in and for Sedgwick County, Kansas, this 15th day of July, 1970.

My Commission Expires:
 March 25, 1972

Catherine Darcey
 Notary Public - Catherine Darcey