


WELL PLUGGING RECORD

Information Completely
Reviewed Affidavit
and Report to:
Conservation Division
State Corporation Commission
211 No. Broadway
Wichita, Kansas

Ness County, Sec 14 Twp. 18S Rge. 26 (E) W (W)
Location as 'NE/CNW/SE' of fraction from lines W/2 SE SE
Lease Owner Thor Corp.
Lease Name Thompson Well No. 2
Office Address E-10 th St. Great Bend, Ka.
Character of Well (completed as Oil, Gas or Dry Hole) Oil
Date well completed Oct. 11, 1950
Application for plugging filed May 27, 1963
Application for plugging approved May 29, 1963
Plugging commenced June 5, 1963
Plugging completed June 7, 1963
Reason for abandonment of well or producing formation Oil depleted.

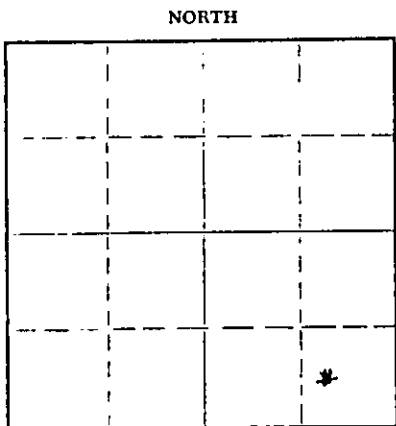

Locate well correctly on above
Section Plat

If a producing well is abandoned, date of last production Jan. 1, 1957
Was permission obtained from the Conservation Division or its agents before plugging was com-
menced? Yes

Name of Conservation Agent who supervised plugging of this well Eldon Petty
Producing formation Miss. Depth to top _____ Bottom _____ Total Depth of Well 4437' Feet
Show depth and thickness of all water, oil and gas formations. 4446

OIL, GAS OR WATER RECORDS

CASING RECORD

FORMATION	CONTENT	FROM	TO	SIZE	PUT IN	PULLED OUT
				13 5/8	78'	None
				5 1/2	4446'	801'

Describe in detail the manner in which the well was plugged, indicating where the mud fluid was placed and the method or methods used in introducing it into the hole. If cement or other plugs were used, state the character of same and depth placed, from _____ feet to _____ feet for each plug set.

Plugged back with sand from 4446' to 4425'. Mixed and dumped 4 ex. cement from 4425' to 4393'. Pulled casing to 500'. Mixed and circulated 15 ex. of gel mud. Mixed and pumped in 30 ex. cement from 500' to 465'. Pulled casing to 180'. Mixed and pumped in 30 ex. cement from 180' to 145'. Pulled rest of casing. Bailed off fluid to 23'. Set 10' rock bridge from 23' to 13'. Mixed and dumped 10 ex. cement from 13' to base cellar.

STATE CORPORATION COMMISSION
WICHITA, KANSAS

JUN 20 1963

6-20-63

CONSERVATION DIVISION
WICHITA, KANSAS

(If additional description is necessary, use back of this sheet)

Name of Plugging Contractor Ace Pipe Pulling Co.
Address Box 304 Great Bend, Ks.

STATE OF Kansas, COUNTY OF Barton, ss.
Russell D. Hoberecht (employee of owner) or (owner or operator) of the above-described well, being first duly sworn on oath, says: That I have knowledge of the facts, statements, and matters herein contained and the log of the above-described well as filed and that the same are true and correct. So help me God.

(Signature) Russell D. Hoberecht

Box 304 Great Bend, Ks.
(Address)

SUBSCRIBED AND SWORN TO before me this 19th day of June, 19 63.

Shirley V. Maier
Shirley V. Maier
Notary Public.

My commission expires March 1, 1966

G. THOMPSON NO. 2

Center of the SW $\frac{1}{4}$ SE $\frac{1}{4}$ SE $\frac{1}{4}$ Sec. 14-18S-26W, Ness County, Kansas

Rigging up Rotary Tools 9-15-50
 Tearing down Rotary Tools 10-2-50
 Rigging up Cable Tools 10-6-50
 Tearing down Cable Tools 10-11-50

Run 2 Jts. 13 5/8" surface pipe. Set at 78' and cemented with 75 ex cement
 Run 146 Jts. 4468.44' of 5 1/2" casing. Set at 8' off bottom and cemented with 75 ex. cement.

<u>FORMATION</u>	<u>FROM</u>	<u>TO</u>
Surface clay and sand	0	101
Shale and sand	101	850
Shale and lime shells	850	1300
Redbed, shale and shells	1300	1620
Redbed and shale	1620	1820
Lime and shale	1820	2750
Lime	2750	2807
Lime and shale	2807	2865
Lime	2865	2955
Lime, (broken)	2955	3065
Broken lime and shale	3065	3125
Shale	3125	3245
Lime and shale	3245	3415
Shale	3415	3555
Lime and shale	3555	3641
Shale and broken lime	3641	3690
Lime and shale	3690	3775
Lime	3775	3802
Lime and shale	3802	3890
Lime	3890	4155
Shale	4155	4160
Lime, hard	4160	4370
Lime and shale	4370	4415
Lime, cherty	4415	4447 Total Depth

I, Don S. Picker, hereby certify that the above Log is true and correct, to the best of my knowledge and belief.

Subscribed and sworn to before me this 16th day of February, 1951.

Notary Public

 Notary Public

My commission expires: March 22, 1952