


WELL PLUGGING RECORD

Give All Information Completely
Make Required Affidavit
Mail or Deliver Report to:
Conservation Division
State Corporation Commission
P. O. Box 17027
Wichita, Kansas 67217
NORTH

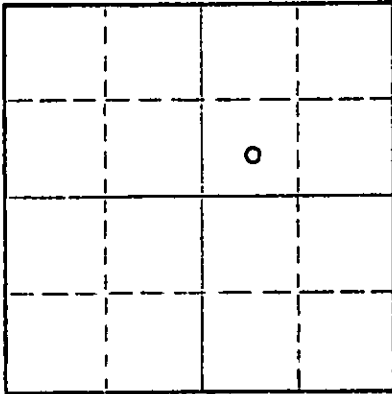

Locate well correctly on above
Section Plat

Ness County, Sec. 12 Twp. 18 Rge. 26W (E) XX(W)
Location as "NE/CNW/SW" or footage from lines C SW NE
Lease Owner PICKRELL DRILLING COMPANY
Lease Name Norton "B-C" Unit Well No. #5
Office Address 705 Fourth Nat'l Bank Bldg. Wichita, Ks. 67202
Character of Well (completed as Oil, Gas or Dry Hole) Dry Hole
Date well completed 11-16-74 19
Application for plugging filed 11-16-74 19
Application for plugging approved 11-16-74 19
Plugging commenced 11-16-74 19
Plugging completed 11-16-74 19
Reason for abandonment of well or producing formation Dry Hole

If a producing well is abandoned, date of last production 19
Was permission obtained from the Conservation Division or its agents before plugging was commenced? Yes

Name of Conservation Agent who supervised plugging of this well Leo F. Massey
Producing formation _____ Depth to top _____ Bottom _____ Total Depth of Well 4470 Feet
Show depth and thickness of all water, oil and gas formations.

OIL, GAS OR WATER RECORDS

CASING RECORD

FORMATION	CONTENT	FROM	TO	SIZE	PUT IN	PULLED OUT
				8 5/8	220'	

Describe in detail the manner in which the well was plugged, indicating where the mud fluid was placed and the method or methods used in introducing it into the hole. If cement or other plugs were used, state the character of same and depth placed, from _____ feet to _____ feet for each plug set.

70 sacks at 720'.
20 sacks at 215'.
40 sacks w/bridge plug at 40'.
Job completed 2:45 PM 11-16-74.

RECEIVED
STATE CORPORATION COMMISSION
11-27-74
CONSERVATION DIVISION
WICHITA, KANSAS

(If additional description is necessary, use BACK of this sheet)
Name of Plugging Contractor PICKRELL DRILLING COMPANY
Address 705 Fourth Nat'l Bank Bldg. Wichita, Ks. 67202

STATE OF Kansas, COUNTY OF Sedgwick, ss.
C. W. Sebitts (employee of owner) or (owner or operator) of the above-described well, being first duly sworn on oath, says: That I have knowledge of the facts, statements, and matters herein contained and the log of the above-described well as filed and that the same are true and correct. So help me God.

(Signature) C.W. Sebitts
705 Fourth Nat'l Bank Bldg. Wichita, Ks. 67202
(Address)

SUBSCRIBED AND SWORN TO before me this 25 day of November, 19 74

My commission expires August 19, 1975

HELEN L. MARTIN
NOTARY PUBLIC
Sedgwick County, Kans.
My Comm. Expires Aug. 19, 1975

Helen L. Martin
Notary Public.

ROTARY DRILLING LOG

COMPANY: PICKRELL DRILLING COMPANY
705 FOURTH NAT'L BANK BLDG.
WICHITA, KANSAS 67202
LOCATION: NORTON "B-C" UNIT #5
C SW NE 12-18S-26W
Ness, County, Kansas

Rotary Drilling Commenced 11-7-74
Rotary Drilling Completed 11-16-74

CONTRACTOR: **PICKRELL DRILLING COMPANY**
Wichita, Kansas

CASING RECORD: (6 joints) 8 5/8 surface casing set at 220' and cemented with 150 sacks cement. Job completed 11-7-74 @ 11:50 PM.

LOG

(Figures indicate bottom of formation — measurements from top of rotary bushing.)

85	Top soil - Post Rock	C. F. S.
223	Shale	
730	Shale & Sand Stringers	4234'
1180	Shale & Red Bed	4375'
1235	Blaine	4394'
1310	Shale	4464'
1350	Sand	4470'
1818	Shale	
1850	Anhy	
2100	Shale	
2455	Shale & Lime Streaks	
2555	Lime & Shale	
2760	Shale	
2925	Lime & Shale	
3100	Lime & Shale	
3250	Shale & Lime	
3425	Lime & Shale	
3545	Shale & Lime	
3733	Shale & Sand Lime	
3885	Lime & Shale	
3960	Lime & Shale	
4050	Lime & Shale	
4140	Lime	
4215	Lime & Shale Streaks	
4270	Lime	
4340	Lime	
4385	Lime	
4395	Lime	
4435	Lime	
4441	Lime	
4461	Congl merate	
4470	Mississippi	

RECEIVED
STATE CORPORATION COMMISSION
NOV 27 1974
CONSERVATION DIVISION
Wichita, Kansas

The undersigned, C. W. Sebitts, Attorney-in-Fact for PICKRELL DRILLING COMPANY, hereby certifies in behalf of said Company, that the above is a true and correct log of the formation encountered in drilling the above well as reflected by the Daily Drilling Reports.

PICKRELL DRILLING COMPANY
By [Signature]
C. W. Sebitts Attorney-in-Fact

STATE OF KANSAS }
COUNTY OF SEDGWICK } ss.:

On this 25 day of November, 1974, before me the undersigned, a Notary Public, in and for

the County and State aforesaid, personally appeared C. W. Sebitts, to me known to be the identical person who subscribed the name of PICKRELL DRILLING COMPANY to the foregoing instrument as its Attorney-in-Fact and acknowledged to me that he executed the same as his free and voluntary act and deed, and as the free and voluntary act and deed of such company, for the uses and purposes therein set forth.

Given under my hand and seal of office the day and year last above written.

My commission expires: August 19, 1975
HELEN L. MARTIN
NOTARY PUBLIC
Sedgwick County, Kans.
My Comm. Expires Aug. 19, 1975

[Signature]
Helen L. Martin
Notary Public