

15-135-30028-0000


Give All Information Completely  
Make Required Affidavit  
Mail or Deliver Report to:  
Conservation Division  
State Corporation Commission  
211 No. Broadway  
Wichita, Kansas

WELL PLUGGING RECORD

Ness County. Sec. 7 Twp. 18 Rge. 26 (X) (E) (W)  
Location as "NE/CNW&SW" or footage from lines SW SW

Lease Owner J. L. Armer  
Lease Name Hays Well No. 1  
Office Address Wichita, Kansas  
Character of Well (completed as Oil, Gas or Dry Hole) Dry  
Date well completed 4-12 19 65  
Application for plugging filed 4-12 19 65  
Application for plugging approved 4-12 19 65  
Plugging commenced 4-12 19 65  
Plugging completed 4-12 19 65  
Reason for abandonment of well or producing formation None

NORTH

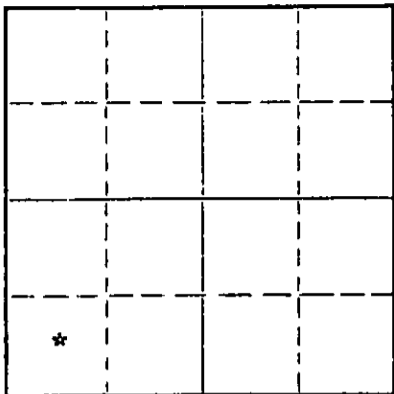

Locate well correctly on above Section Plat

If a producing well is abandoned, date of last production None 19\_\_\_\_  
Was permission obtained from the Conservation Division or its agents before plugging was commenced? Yes

Name of Conservation Agent who supervised plugging of this well Eldon Petty  
Producing formation \_\_\_\_\_ Depth to top \_\_\_\_\_ Bottom \_\_\_\_\_ Total Depth of Well \_\_\_\_\_ Feet  
Show depth and thickness of all water, oil and gas formations.

OIL, GAS OR WATER RECORDS

CASING RECORD

FORMATION	CONTENT	FROM	TO	SIZE	PUT IN	PULLED OUT
		0	200'	8 5/8	200	0

Describe in detail the manner in which the well was plugged, indicating where the mud fluid was placed and the method or methods used in introducing it into the hole. If cement or other plugs were used, state the character of same and depth placed, from \_\_\_\_\_ feet to \_\_\_\_\_ feet for each plug set.

Fill hole with heavy mud to 200', 1/2 sack hulls, plug and 20 sacks cement. Mud hole to 100', 1/2 sack hulls, plug and 20 sacks cement. Mud hole to 25', 1/2 sack hulls, plug and 10 sacks cement.

Plugging complete at 11:00 A. M. - 4-12-65

APR 27  
4-27-65

(If additional description is necessary, use BACK of this sheet)

Name of Plugging Contractor Merry "A" Drilling, Inc.  
Address Russell, Kansas

STATE OF KANSAS COUNTY OF RUSSELL, ss.  
Joe K. Branum (Employee of owner, or (owner or operator)) of the above-described

well, being first duly sworn on oath, says: That I have knowledge of the facts, statements, and matters herein contained and the log of the above-described well as filed and that the same are true and correct. So help me God.

(Signature) [Signature]  
Russell, Kansas  
(Address)

SUBSCRIBED AND SWORN TO before me this 19th day of April, 19 65

My commission expires November 13, 1967. Mary Anna Branum Notary Public.

STATE OF KANSAS  
 APR 20 1965  
 DEPARTMENT OF REVENUE

W E L L L O G

OPERATOR: J. L. Armer  
 Wichita, Kansas

CONTRACTOR: Merry "A" Drilling, Inc.  
 Russell, Kansas

LEASE: Hays

COMMENCED: March 25, 1965

LOCATION: SW SW, Sec. 7-18-26  
 Ness County, Kansas

COMPLETED: April 12, 1965

DEPTHS & FORMATIONS

Clay & Shale	200	Lime	3305
Shale & Sand	885	Lime Shale	3853
Red Bed	1330	Chalk	3939
Shale	1940	Lime & Shale	4028
Anhydrite	2120	Lime	4570
Shale	2405	Lime & Chert (R.T.D.)	4600
Lime & Shale	3230		

STATE OF KANSAS )  
 )  
 COUNTY OF RUSSELL) ss...

Joe K. Branum, being first duly sworn on oath says: "That I have knowledge of the facts, statements and matters herein contained and the log of the above described well as filed and that the same are true and correct".

Joe K. Branum  
 Joe K. Branum

Subscribed and sworn before me this 19th day of April, 1965.

Mary Anna Branum  
 Notary Public

My Commission Expires: November 13, 1967.