


STATE OF KANSAS  
STATE CORPORATION COMMISSION

Give All Information Completely  
Make Required Affidavit  
Mail or Deliver Report to:  
Conservation Division  
State Corporation Commission  
211 No. Broadway  
Wichita, Kansas

WELL PLUGGING RECORD

NORTH

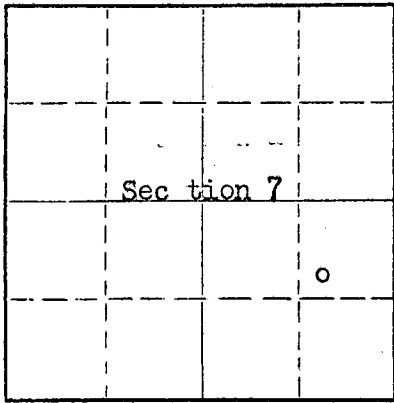

Locate well correctly on above  
Section Plat

RUSH County, Sec. 7 Twp. 17S Rge. 16E #11 (W)

Location as "NE/CNWxSWx" of footage from lines. Approx. SW NE SE  
Lease Owner. Petroleum, Inc.  
Lease Name. Hopkins "B" Well No. 1  
Office Address. R. R. #2 Great Bend, Kansas  
Character of Well (completed as Oil, Gas or Dry Hole) Dry Hole  
Date well completed July 11, 1962  
Application for plugging filed July 11, 1962  
Application for plugging approved July 11, 1962  
Plugging commenced July 10, 1962  
Plugging completed July 11, 1962  
Reason for abandonment of well or producing formation No producible formations

If a producing well is abandoned, date of last production \_\_\_\_\_ 19\_\_\_\_  
Was permission obtained from the Conservation Division or its agents before plugging was commenced? Yes

Name of Conservation Agent who supervised plugging of this well Mr. Eldon Petty Hays, Kansas  
Producing formation \_\_\_\_\_ Depth to top \_\_\_\_\_ Bottom \_\_\_\_\_ Total Depth of Well 3120 Feet  
Show depth and thickness of all water, oil and gas formations.

OIL, GAS OR WATER RECORDS

CASING RECORD

FORMATION	CONTENT	FROM	TO	SIZE	PUT IN	PULLED OUT
				8-5/8"	356'	None

Describe in detail the manner in which the well was plugged, indicating where the mud fluid was placed and the method or methods used in introducing it into the hole. If cement or other plugs were used, state the character of same and depth placed, from \_\_\_\_\_ feet to \_\_\_\_\_ feet for each plug set.

Mudded up with heavy mud to 350' followed by a wooden plug. Placed 25 sacks of cement, thru drill pipe on top of plug, ~~#####~~ Mudded up with heavy mud to 10', followed by a wooden plug. Placed 1 1/4 sacks of hulls on top of plug followed by 10 sacks of cement to base of well cellar.

RECEIVED  
STATE CORPORATION COMMISSION  
JUL 25 1962  
CONSERVATION DIVISION  
Wichita, Kansas

Name of Plugging Contractor ~~#####~~ Garvey Drilling Co.  
Address R. R. #2 Great Bend, Kansas  
(If additional description is necessary, use BACK of this sheet)

STATE OF KANSAS, COUNTY OF BARTON, ss.  
Monte Chadd (employee of owner) or ~~#####~~ of the above-described well, being first duly sworn on oath, says: That I have knowledge of the facts, statements, and matters herein contained and the log of the above-described well as filed and that the same are true and correct. So help me God.  
(Signature) Monte Chadd, District Production Foreman  
R. R. #2, Great Bend, Kansas  
(Address)

SUBSCRIBED AND SWORN to before me this 21st day of July, 1962  
My commission expires April 14, 1963  
Notary Public.

# WELL LOG

15-165-0034-0000

COMPANY PETROLEUM, INCORPORATED

SEC. 7 T. 17S R. 16W

FARM HOPKINS "B" NO. 1

LOC. Approx. SW, NE, SE


TOTAL DEPTH 3120'

COUNTY RUSH CO., KANSAS

COMM. July 5, 1962

COMP. July 11, 1962

CONTRACTOR GARVEY DRILLING COMPANY

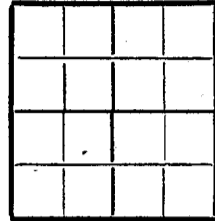

CASING 8-5/8" @ 356' w/250 sax.

ELEVATION 2069' DF

PRODUCTION D & A

FIGURES INDICATE BOTTOM OF FORMATIONS

45	Surface clay
300	Shale
358	Shale & shells
1220	Red bed & sand
1250	Anhydrite
1515	Shale & shells
1890	Shale
2325	Shale & lime
2392	Lime
2795	Shale & lime
2940	Lime & shale
3120	Shale & lime
3120	T. D.

**RECEIVED**  
STATE CORPORATION COMMISSION

JUL 25 1962

CONSERVATION DIVISION  
Wichita, Kansas

State of KANSAS }  
County of BARTON } SS

I, VERNE A. MORRIS of GARVEY DRILLING COMPANY  
upon oath state the above and foregoing is a true and correct copy of the log of the #1 HOPKINS "B" well.

Subscribed and sworn to before me this 19th day of July 19 62

My Commission Expires: April 14, 1963

*Arthur J. Miles*  
NOTARY PUBLIC