


WELL PLUGGING RECORD

Give All Information Completely
Make Required Affidavit
Mail or Deliver Report to:
Conservation Division
State Corporation Commission
212 No. Market
Wichita, Kansas

Rush County. Sec. 7 Twp. 17S Rge. 16W (E) (W)
Location as "NE/CNW/SW" or footage from lines SW NE SE
Lease Owner Frontier Oil
Lease Name Hapkins Well No. 1
Office Address 1720 Wichita Plaza
Character of Well (completed as Oil, Gas or Dry Hole) Gas
Date well completed 2-23 1965
Application for plugging filed 9-23 1976
Application for plugging approved _____ 19____
Plugging commenced 10-8 1976
Plugging completed 10-8 1976
Reason for abandonment of well or producing formation Non-commercial

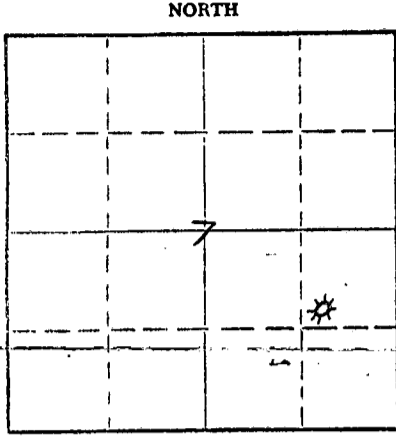

Locate well correctly on above Section Plat

If a producing well is abandoned, date of last production _____ 19____
Was permission obtained from the Conservation Division or its agents before plugging was commenced? Yes

Name of Conservation Agent who supervised plugging of this well Leo Massey
Producing formation Topoka Depth to top 3084 Bottom 3324 Total Depth of Well 3669 Feet
Show depth and thickness of all water, oil and gas formations.

OIL, GAS OR WATER RECORDS

CASING RECORD

FORMATION	CONTENT	FROM	TO	SIZE	PUT IN	PULLED OUT
		0	356	8 5/8"	356'	0
		0	3232	4 1/2"	3232	0

Describe in detail the manner in which the well was plugged, indicating where the mud fluid was placed and the method or methods used in introducing it into the hole. If cement or other plugs were used, state the character of same and depth placed, from _____ feet to _____ feet for each plug set.

Mixed 50 sz cement and pumped down annulus between 8 5/8" and 4 1/2" casing. Mixed 4 sz balls & 20 sz gel followed by 80 sz cement & pumped down 4 1/2" 100 lb pump press. 50" shut in press.

RECEIVED
STATE CORPORATION COMMISSION


OCT 12 1976

CONSERVATION DIVISION
Wichita, Kansas

(If additional description is necessary, use BACK of this sheet)
Name of Plugging Contractor Allied Cementing Co.
Address Russell, Kans.

STATE OF KANSAS COUNTY OF SEDGWICK, ss.
Maxine V. Starr (employee of owner) or (owner or operator) of the above-described

well, being first duly sworn on oath, says: That I have knowledge of the facts, statements, and matters herein contained and the log of the above-described well as filed and that the same are true and correct. So help me God.

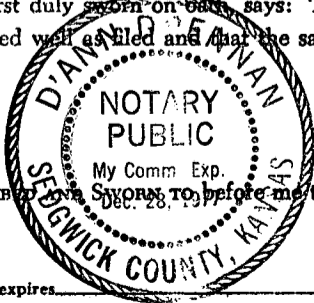

(Signature) Maxine V. Starr

1720 Kansas State Bank Building, Wichita
(Address) Kansas

Subscribed and sworn to before me this 11th day of October, 1976

Dianne Brennan
Notary Public.

My commission expires _____

