


STATE OF KANSAS
STATE CORPORATION COMMISSION
CONSERVATION DIVISION
P. O. BOX 17027
WICHITA, KANSAS 67217

FORM CP-4

WELL PLUGGING RECORD

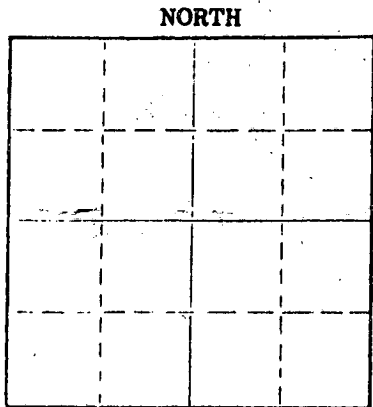

Locate well correctly on above Section Plat

Rush County, Sec. 18 Twp. 17 Rge. 16 (E) (W) X
Location as "NE/CNW&SW" or footage from lines NW/SW/NW
Lease Owner FRONTIER OIL COMPANY
Lease Name ERNT "B" Well No. 1
Office Address P. O. Box 312, Otis, Kansas 67565
Character of Well (completed as Oil, Gas or Dry Hole)
Date well completed 19
Application for plugging filed November 5, 19 75
Application for plugging approved 19
Plugging commenced November 11, 19 75
Plugging completed November 14, 19 75
Reason for abandonment of well or producing formation Depleted

If a producing well is abandoned, date of last production 19
Was permission obtained from the Conservation Division or its agents before plugging was commenced? Yes

Name of Conservation Agent who supervised plugging of this well Leo Massey
Producing formation Depth to top Bottom Total Depth of Well 3640 Feet
Show depth and thickness of all water, oil and gas formations.

OIL, GAS OR WATER RECORDS

CASING RECORD

FORMATION	CONTENT	FROM	TO	SIZE	PUT IN	PULLED OUT
				8 5/8	359	-0-
				4 1/2	3154	1911.35'


Describe in detail the manner in which the well was plugged, indicating where the mud fluid was placed and the method or methods used in introducing it into the hole. If cement or other plugs were used, state the character of same and depth placed, from feet to feet for each plug set.

Well was plugged back to 2800' with sand and 3 sacks cement. Shot casing at 1995 and 1915'. Pulled a total of 49 joints of 4 1/2" casing. Squeezed well with 20 sacks gel, 3 sacks hulls, 60 sacks cement, 5 sacks gel and 15 sacks cement.

(If additional description is necessary, use BACK of this sheet)
Name of Plugging Contractor Rockhold Engineering, Inc.
Address P. O. Box 698, Great Bend, Kansas 67530

STATE OF Kansas COUNTY OF Barton
James W. Rockhold (employee of owner) or (owner/operator) of the above-described

well, being first duly sworn on oath, says: That I have knowledge of the facts, statements, and matters herein contained and the log of the above-described well as filed and that the same are true and correct. So help me God.

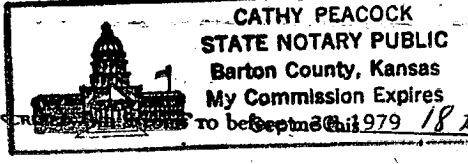

(Signature) James W. Rockhold
Box 698, Gt. Bend, Kansas 67530
(Address)

My commission expires September 30, 1979
Cathy Peacock Notary Public

RECEIVED
STATE CORPORATION COMMISSION
NOV 19 1975
CONSERVATION DIVISION
Wichita, Kansas

DRILLERS LOG

No. 1 Erni "B" - WASHDOWN

CASING RECORD:	COMPANY: Frontier Oil Company	DESCRIPTION:
(8-5/8" @ 359' w/225 sx. cmt.)	CONTRACTOR: Red Tiger Drilling Company	NW SW NW 18-17S-16W Rush County, Kansas
4-1/2" @ 3149' w/150 sx. cmt.	COMMENCED: July 14, 1975	
TOTAL DEPTH: 3640'	COMPLETED: July 22, 1975	ELEVATION: 2026' Gr.

<u>FORMATION</u>	<u>FROM</u>	<u>TO</u>	<u>REMARKS</u>
Cement	0	210	<p>RECEIVED STATE CORPORATION COMMISSION</p> <p>OCT 31 1975</p> <p>CONSERVATION DIVISION Wichita, Kansas</p>
Cement & Plug	210	359	
Washing & Reaming Down Hole	359	3079	
Lime & Shale	3079	3190	
Lime	3190	3270	
Lime & Shale	3270	3315	
Lime	3315	3560	
Lime & Chert	3560	3640	

I certify that this is a true and correct copy of the above log to the best of my knowledge.

RED TIGER DRILLING COMPANY

Linda H. Dickens
Linda H. Dickens

Subscribed and sworn to before me this 19th day of August, 1975.

D'Ann Drennan
Notary Public

My Commission Expires:

December 28, 1977

