

15.165-011636-0000

STATE OF KANSAS
STATE CORPORATION COMMISSION

Give All Information Completely
Make Required Affidavit
Mail or Deliver Report to:
Conservation Division
State Corporation Commission
211 No. Broadway
Wichita, Kansas

WELL PLUGGING RECORD

RUSH County. Sec. 18 Twp. 17S Rge. 16W (X) X(W)

Location as "NE/CNW%SW%" or footage from lines NW SW NW

Lease Owner PETROLEUM, INC.

Lease Name ERNI "C" Well No. 1

Office Address ROUTE 2, GREAT BEND, KANSAS

Character of Well (completed as Oil, Gas or Dry Hole) DRY HOLE

Date well completed APRIL 17, 19 62

Application for plugging filed APRIL 17, 19 62

Application for plugging approved APRIL 17, 19 62


Plugging commenced APRIL 17, 19 62

Plugging completed APRIL 17, 19 62

Reason for abandonment of well or producing formation NO PRODUCIBLE FORMATIONS

If a producing well is abandoned, date of last production ----- 19

Was permission obtained from the Conservation Division or its agents before plugging was commenced? YES

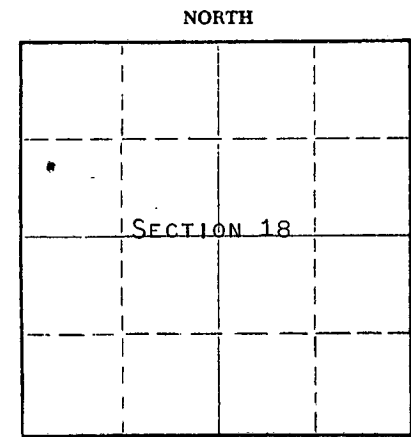

Locate well correctly on above Section Plat

Name of Conservation Agent who supervised plugging of this well ELDON PETTY

Producing formation --- Depth to top --- Bottom --- Total Depth of Well 3079 Feet

Show depth and thickness of all water, oil and gas formations.

OIL, GAS OR WATER RECORDS

CASING RECORD

FORMATION	CONTENT	FROM	TO	SIZE	PUT IN	PULLED OUT
				8-5/8"	359'	NONE

Describe in detail the manner in which the well was plugged, indicating where the mud fluid was placed and the method or methods used in introducing it into the hole. If cement or other plugs were used, state the character of same and depth placed, from feet to feet for each plug set.

MUDDED UP WITH HEAVY MUD TO 359', FOLLOWED BY A WOODEN PLUG.
PLACED 20 SACKS OF CEMENT THROUGH DRILL PIPE ON TOP OF WOODEN PLUG.
MUDDED UP WITH HEAVY MUD TO 40' FOLLOWED BY A WOODEN PLUG. PLACED
1/4 SACK OF HULLS ON TOP OF WOODEN PLUG, FOLLOWED BY 10 SACKS OF
CEMENT TO BASE OF WELL CELLAR.

RECEIVED
STATE CORPORATION COMMISSION
APR 30 1962
CONSERVATION DIVISION
Wichita, Kansas

(If additional description is necessary, use BACK of this sheet)

Name of Plugging Contractor GARVEY DRILLING COMPANY

Address ROUTE 2, GREAT BEND, KANSAS

STATE OF KANSAS, COUNTY OF BARTON, ss.

DON SEARLE (employee of owner) or (owner or operator) of the above-described well, being first duly sworn on oath, says: That I have knowledge of the facts, statements, and matters herein contained and the log of the above-described well as filed and that the same are true and correct. So help me God. DON SEARLE, DIST. PROD. SUPT.

(Signature) Don Searle

ROUTE 2, GREAT BEND, KANSAS (Address)

SUBSCRIBED AND SWORN TO before me this 27TH day of APRIL, 19 62

My commission expires APRIL 14, 1963.

Arthur J. Miles Notary Public.



COMPANY PETROLEUM, INCORPORATED

SEC. 18 T. 17S R. 16W

FARM ERNI "C" NO. 1


LOC. NW, SW, NW

TOTAL DEPTH 3079'

COUNTY RUSH CO., KANSAS

COMM. April 11, 1962 COMP. April 17, 1962

CONTRACTOR GARVEY DRILLING COMPANY

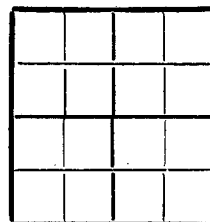

CASING 8-5/8" @ 359' w/225 sax.

ELEVATION 2028' DF

PRODUCTION D & A

FIGURES INDICATE BOTTOM OF FORMATIONS

50	Surface clay
280	Shale w/sand streaks
359	Shale & shells
560	Shale
840	Sand
1180	Red bed & shale
1205	Anhydrite
1910	Shale & shells
2100	Shale & lime
2320	Lime
2873	Shale & lime
3063	Lime & shale
3079	Lime
3079	T. D.

RECEIVED
STATE CORPORATION COMMISSION
APR 30 1962
CONSERVATION DIVISION
Wichita, Kansas

State of KANSAS
County of BARTON } ss

I, VERNE A. MORRIS of GARVEY DRILLING COMPANY

upon oath state the above and foregoing is a true and correct copy of the log of the #1 ERNI "C" well.

Subscribed and sworn to before me this 25th day of April 19 62

My Commission Expires: April 14, 1963

Verne A. Morris
Arthur J. Wales
NOTARY PUBLIC