


STATE OF KANSAS
STATE CORPORATION COMMISSION

Form CP-4

Give All Information Completely
Make Required Affidavit
Mail or Deliver Report to:
Conservation Division
State Corporation Commission

WELL PLUGGING RECORD

P. O. Box 17027
Wichita, Kansas 67217
NORTH

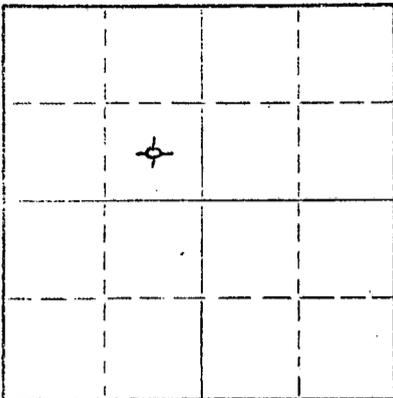

Locate well correctly on above
Section Plat

Ness County. Sec. 21 Twp. 20S Rge. 21 (W)
Location as "NE/CNWSW" or footage from lines. C SE NW
Lease Owner Mack Oil Co.
Lease Name Betz Well No. 1
Office Address 812 Union Center Bldg, Wichita, KS 67202
Character of Well (completed as Oil, Gas or Dry Hole) Dry Hole
Date well completed 12-9-74 19
Application for plugging filed 12-9-74 19
Application for plugging approved 12-9-74 19
Plugging commenced 12-9-74 19
Plugging completed 12-9-74 19
Reason for abandonment of well or producing formation commercial quantities of oil not found
If a producing well is abandoned, date of last production 19
Was permission obtained from the Conservation Division or its agents before plugging was commenced? YES

Name of Conservation Agent who supervised plugging of this well Leo Massey-Hays, KS
Producing formation _____ Depth to top _____ Bottom _____ Total Depth of Well 4468 Feet
Show depth and thickness of all water, oil and gas formations.

OIL, GAS OR WATER RECORDS

CASING RECORD

FORMATION	CONTENT	FROM	TO	SIZE	PUT IN	PULLED OUT
				8-5/8"	351'	

Describe in detail the manner in which the well was plugged, indicating where the mud fluid was placed and the method or methods used in introducing it into the hole. If cement or other plugs were used, state the character of same and depth placed, from _____ feet to _____ feet for each plug set.

Plugged with 70 sx. @ 600', 20 sx. @ 240', 10 sx. @ 40', with 50-50 pos, 6% gel.

RECEIVED
STATE CORPORATION COMMISSION
DEC 13 1974
CONSERVATION DIVISION
Wichita, Kansas


(If additional description is necessary, use BACK of this sheet)

Name of Plugging Contractor Rains & Williamson Oil Co., Inc.
Address 435 Page Court, 220 W. Douglas, Wichita, KS 67202

STATE OF Kansas COUNTY OF Sedgwick, ss.
Wilson Rains, President (employee of owner) or (owner or operator) of the above-described

well, being first duly sworn on oath, says: That I have knowledge of the facts, statements, and matters herein contained and the log of the above-described well as filed and that the same are true and correct. So help me God.

(Signature) Wilson Rains
Wilson Rains
435 Page Court, 220 W. Douglas, Wichita, KS
(Address)

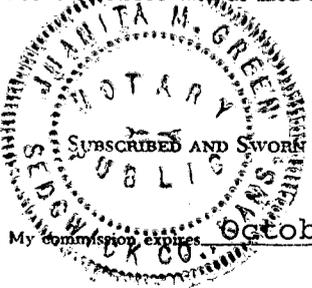

Subscribed and sworn to before me this 11th day of December, 1974.
October 4, 1975
Juanita M. Green Notary Public.

15-135-20872-0000
WELL LOG

COMPANY Mack Oil Co.

SEC. 21 T.20S R. 21W
LOC. C SE NW

FARM Betz

NO. 1


RIG. NO. & 7

TOTAL DEPTH 4468'

COMM. 11-27-74

COMP. 12-9-74

COUNTY Ness
KANSAS

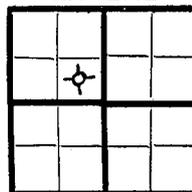

CONTRACTOR Rains & Williamson Oil Co., Inc.

CASING

20 10
15 8-5/8" @ 351' w/225 sx. 2% gel, 3% cc ELEVATION 2240'
12 6
13 5

PRODUCTION D & A

FIGURES INDICATE BOTTOM OF FORMATIONS

Shale & Post Rock	130
Shale	1450
Anhydrite	1471
Shale	2165
Lime & Shale	2258
Shale	2867
Shale & Lime	3200
Lime & Shale	3775
Lime	4380
Lime & Chert	4468
<u>Rotary Total Depth</u>	<u>4468</u>

RECEIVED
STATE CORPORATION COMMISSION
DEC 13 1974
CONSERVATION DIVISION
Wichita, Kansas

State of Kansas
County of Sedgwick } ss:

I, Wilson Rains, President of the Rains & Williamson Oil Company, Inc.

upon oath state that the above and foregoing is a true and correct copy of the log of the Betz #1 well.

Wilson Rains
Wilson Rains
19 74



Subscribed and sworn to before me this 11th day of December
My Commission Expires: October 4, 1975

Juanita M. Green
NOTARY PUBLIC
Juanita M. Green