

15.135-20064-0000


STATE OF KANSAS  
STATE CORPORATION COMMISSION

Form CP-4

WELL PLUGGING RECORD

Give All Information Completely  
Make Required Affidavit  
Mail or Deliver Report to:  
Conservation Division  
State Corporation Commission  
212 No. Market  
Wichita, Kansas

NORTH

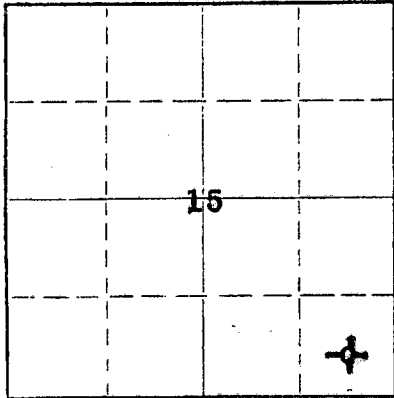

Locate well correctly on above  
Section Plat

Ness County. Sec. 15 Twp. 20S Rge. 21W (W)  
Location as "NE/CNW/SW" or footage from lines 150' S of C SE SE  
Lease Owner D. R. Lauck Oil Company, Inc.  
Lease Name Stearns Well No. 1  
Office Address 301 S. Broadway, Wichita, Kansas  
Character of Well (completed as Oil, Gas or Dry Hole) Dry Hole  
Date well completed October 18, 19 67  
Application for plugging filed October 18, 19 67  
Application for plugging approved October 18, 19 67  
Plugging commenced October 18, 19 67  
Plugging completed October 18, 19 67  
Reason for abandonment of well or producing formation Dry Hole

If a producing well is abandoned, date of last production \_\_\_\_\_ 19\_\_\_\_  
Was permission obtained from the Conservation Division or its agents before plugging was commenced? Yes

Name of Conservation Agent who supervised plugging of this well Leo Massey  
Producing formation \_\_\_\_\_ Depth to top \_\_\_\_\_ Bottom \_\_\_\_\_ Total Depth of Well 4440 Feet  
Show depth and thickness of all water, oil and gas formations.

OIL, GAS OR WATER RECORDS

CASING RECORD

FORMATION	CONTENT	FROM	TO	SIZE	PUT IN	PULLED OUT
		0'	340'	8-5/8"	340'	None

Describe in detail the manner in which the well was plugged, indicating where the mud fluid was placed and the method or methods used in introducing it into the hole. If cement or other plugs were used, state the character of same and depth placed, from \_\_\_\_\_ feet to \_\_\_\_\_ feet for each plug set.

4440'-620' Mud  
620'-616' Plug  
616'-576' Cement, 65 sacks  
576'-40' Mud  
40'-36' Plug  
36'-6' Cement, 10 sacks; 4 sacks Gel.  
(Bottom of Cellar)

RECEIVED  
STATE CORPORATION COMMISSION  
OCT 26 1967  
CONSERVATION DIVISION  
WICHITA, KANSAS

(If additional description is necessary, use BACK of this sheet)

Name of Plugging Contractor Halliburton Oil Well Cementing Co.  
Address Great Bend, Kansas

STATE OF KANSAS COUNTY OF SEDGWICK, ss.  
John H. Knightley (employee of owner) or (owner or operator) of the above-described


well, being first duly sworn on oath, says: That I have knowledge of the facts, statements, and matters herein contained and the log of the above-described well as filed and that the same are true and correct. So help me God.

(Signature) John H. Knightley  
301 S. Broadway, Wichita, Kansas  
(Address)

SUBSCRIBED AND SWORN TO before me this 24th day of October, 19 67

My commission expires March 12, 1971.

Stella J. Lypka  
Notary Public.

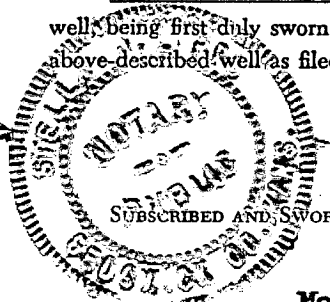

15-135-20864-0000

D. R. Lauck Oil Company, Inc.

Stearns #1

150' S of C SE SE 15-20S-21W  
Ness County, Kansas

Commenced: October 9, 1967  
Completed: October 18, 1967

Casing Record: 340' 8-5/8" Cemented with 200 sacks Cement,  
4 sacks Calcium Chloride.

Elevation: GL 2206; DF 2208; KB 2210.

Drillers Log

Tops

		Sample	Welex
Surface Clay	30		
Post Rock	45		
Shale	162		
Sand Shale	192	Heebner	3749-1539 3746-1536
Shale	250	Toronto	3768-1558 3766-1556
Shale & Red Bed	340	Lansing	3797-1587 3795-1585
Shale	585	Ft. Scott	4307-2097 4306-2096
Red Bed	865	Cherokee Shale	4329-2119 4326-2116
Sand	1060	Reworked	
Red Bed & Sand Streaks	1115	Mississippian	4374-2164 4376-2166
Red Bed	1426	Clean	
Anhydrite	1460	Mississippian	4400-2190 4398-2188
Shale & Shells	2130	Total Depth	4440-2230 4437-2227
Shale & Lime	2245		
Lime & Shale	3125		
Shale & Shells	3210		
Lime & Shale	3905		
Lime	4125	DST - None	
Lime & Shale	4177		
Lime	4210		
Lime & Shale	4365		
Lime & Chert	4391		
Chert Lime	4440 RTD	D&A	

RECEIVED  
STATE CORPORATION COMMISSION

OCT 26 1967

CONSERVATION DIVISION  
Wichita, Kansas