


Give All Information Completely
Make Required Affidavit
Mail or Deliver Report to:
Conservation Division
State Corporation Commission
212 No. Market
Wichita, Kansas

WELL PLUGGING RECORD

NORTH

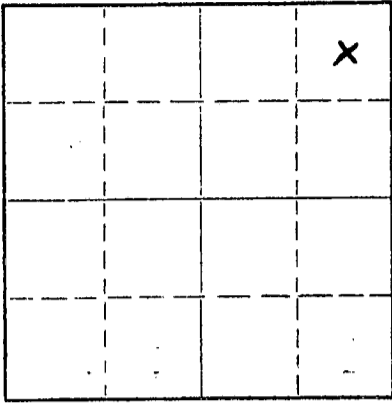

Locate well correctly on above
Section Plat

Ness County. Sec 13 Twp. 20 Rge. 21 (E) W (W)
Location as "NE/CNW%SW%" or footage from lines C NE NE
Lease Owner Pickrell Drilling Co.; Wichita, Kansas
Lease Name Isern 'B' Well No. # 1
Office Address 705 Fourth National Bank Bldg.
Character of Well (completed as Oil, Gas or Dry Hole) Dry Hole
Date well completed _____ 19____
Application for plugging filed April 20 19 70
Application for plugging approved April 20 19 70
Plugging commenced April 23 19 70
Plugging completed April 25 19 70
Reason for abandonment of well or producing formation Dry Hole

If a producing well is abandoned, date of last production _____ 19____
Was permission obtained from the Conservation Division or its agents before plugging was commenced? Yes

Name of Conservation Agent who supervised plugging of this well Leo Massey
Producing formation Mississippian Depth to top 4358 Bottom 4368 Total Depth of Well 4375 Feet
Show depth and thickness of all water, oil and gas formations.

OIL, GAS OR WATER RECORDS

CASING RECORD

FORMATION	CONTENT	FROM	TO	SIZE	PUT IN	PULLED OUT
				8 5/8	261	None
				5 1/2	4368	3237

RECEIVED
STATE CORPORATION COMMISSION
MAY 13 1970
CONSERVATION DIVISION
Wichita, Kansas

Describe in detail the manner in which the well was plugged, indicating where the mud fluid was placed and the method or methods used in introducing it into the hole. If cement or other plugs were used, state the character of same and depth placed, from _____ feet to _____ feet for each plug set.

April 23, 1970 Plug off bottom. Dump sand to 4350'. Mix and dump 5 sx of cement to 4310'.

April 25, 1970 Plug off top. Globe Oil Well Cementing Co. mixed and pumped down 8 5/8" surface casing: 3 sx hulls, 20 sx gel, released plug and 130 sx of cement. Cement contained 6% gel.

(If additional description is necessary, use BACK of this sheet)
Name of Plugging Contractor RUSS CASING PULLING, INC.
Address P.O. BOX 1082 GREAT BEND, KANSAS 67530

STATE OF Kansas COUNTY OF Sedgwick, ss.
Dale M. Robinson (employee of owner) or (owner or operator) of the above-described well, being first duly sworn on oath, says: That I have knowledge of the facts, statements, and matters herein contained and the log of the above-described well as filed and that the same are true and correct. So help me God.

(Signature) Dale M. Robinson
Date May 11 19 70
705 Fourth National Bank Building, Wichita, Kansas
(Address)



Esther Lamone
Notary Public.

ROTARY DRILLING LOG

COMPANY: Pickrell Drlg. Co. & E. H. Adair
705 Fourth National Bank Building
Wichita, Kansas 67202

Rotary Drilling Commenced 3/12/70

Rotary Drilling Completed 3/21/70

LOCATION: Isern "B" No. 1, C NE NE Section 13-20S-21W
Ness County, Kansas

CONTRACTOR: PICKRELL DRILLING COMPANY
Wichita, Kansas

CASING RECORD: Run 9 Jts. 8-5/8" surface casing set @ 266' KB. Cemented with 160 sacks. Completed 6:15 P.M. Circulated.

Run 134 Jts. 14# 5-1/2" casing @ 4366'. Cemented w/125 sacks 50-50 pozmix, 4% gel followed by 35 sacks common. Completed 12:30 A.M. March 21, 1970.

LOG

(Figures indicate bottom of formation — measurements from top of rotary bushing.)

30	Top Soil & Clay		<u>C.F.S.</u>
80	Post Rock		4312
268	Shale & Shells		4355
785	Shale & Red Beds		4365
860	Red Bed		4375
1060	Sand		
1412	Shale		
1443	Anhydrite		<u>S.L.M.</u>
1890	Shale.	Board	3827.81
2260	Shale & Lime	Strap	3825.38
2975	Lime & Shale		2.43 Difference
3175	Shale & Lime		
3320	Lime & Shale		<u>Slope Tests</u>
3530	Shale & Lime		2000
3798	Shale & Sandy Lime		2500
3935	Lime & Shale		3000
4075	Lime		3500
4120	Lime & Shale		4000
4337	Shale & Lime		
4359	Lime & Shale		
4375	Mississippian, RTD		

RECEIVED
STATE CORPORATION COMMISSION
APR 22 1970
CONSERVATION DIVISION
Wichita, Kansas

The undersigned C. W. Sebitts, Attorney-in-Fact for PICKRELL DRILLING COMPANY, hereby certifies in behalf of said Company, that the above is a true and correct log of the formation encountered in drilling the above well as reflected by the Daily Drilling Reports.

PICKRELL DRILLING COMPANY
By [Signature]
C. W. Sebitts Attorney-in-Fact

STATE OF KANSAS }
COUNTY OF SEDGWICK } ss.:

On this 24th day of March, 1970, before me the undersigned, a Notary Public, in and for

the County of Sedgewick, personally appeared C. W. Sebitts, to me known to be the person who subscribed the name of PICKRELL DRILLING COMPANY to the foregoing instrument, and he acknowledged to me that he executed the same as his free and voluntary act and deed, and as the true and lawful agent of such company, for the uses and purposes therein set forth.

Given under my hand and seal of office the day and year last above written.



January 19, 1973

[Signature]
Esther Lamone Notary Public