


STATE OF KANSAS
STATE CORPORATION COMMISSION

WELL PLUGGING RECORD

Give All Information Completely
Make Required Affidavit
Mail or Deliver Report to
Conservation Division
State Corporation Comm.
245 North Water
Wichita, KS 67202

Ness County, Sec. 7 Twp. 20 Rge. 21 XE/W
Location as "NE/CNW/SW" or footage from lines
C/SW SE

Lease Owner Cities Service Oil
Lease Name O'Brien Well No. B-3
Office Address 700 Sutton Pl. Bldg.; 209 E. William;
Character of Well (Completed as Oil, Gas or Dry Hole) Wichita
Dry Hole

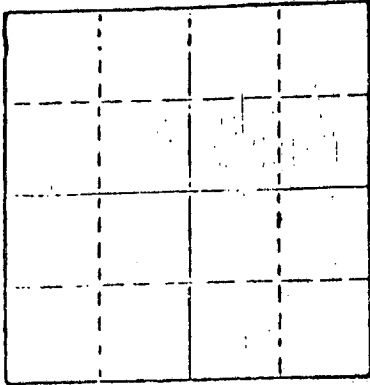

Locate well correctly on above
Section Plat

Date Well completed 7/30 19 79
Application for plugging filed 7/30 19 79
Application for plugging approved 7/30 19 79
Plugging commenced 7/30 19 79
Plugging completed 7/30 19 79
Reason for abandonment of well or producing formation
Dry Hole

If a producing well is abandoned, date of last production 19

Was permission obtained from the Conservation Division or
its agents before plugging was commenced? yes

Name of Conservation Agent who supervised plugging of this well Marion Schmid
Producing formation Depth to top Bottom Total Depth of Well
Show depth and thickness of all water, oil and gas formations.

OIL, GAS OR WATER RECORDS

CASING RECORD

FORMATION	CONTENT	FROM	TO	SIZE	PUT IN'	PULLED OUT
				8 5/8"	314'	

Describe in detail the manner in which the well was plugged, indicating where the mud fluid
was placed and the method or methods used in introducing it into the hold. If cement or other
plugs were used, state the character of same and depth placed, from feet to
feet for each plug set.

- 7/30/79 Mud to 590', plug, plugged with 70 sacks cement.
- 7/30/79 Mud to 325', plug, plugged with 20 sacks cement.
- 7/30/79 Mud to 40', plug, plugged with 10 sacks cement.
- 7/30/79 Plugged rathole with 5 sacks cement.

RECEIVED
STATE CORPORATION COMMISSION

AUG 10 1979

CONSERVATION DIVISION
Wichita, Kansas


(If additional description is necessary, use BACK of this sheet)

Name of Plugging Contractor White & Ellis Drilling, Inc.
Box 448; El Dorado, Ks. 67042

STATE OF Kansas COUNTY OF Butler, ss.
Ernest Sifford (employee of owner) or (owner or operator)
of the above-described well, being first duly sworn on oath, says: That I have knowledge of
the facts, statements, and matters herein contained and the log of the above-described well
as filed and that the same are true and correct. So help me God.

(Signature) Ernest Sifford
El Dorado, Kansas
(Address)

SUBSCRIBED AND SWORN TO before me this 1 day of August, 1979

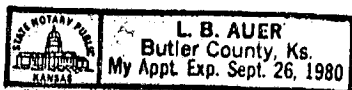

L. B. Auer
Notary Public.

My commission expires

15-135-21675-0000

DRILLERS LOG

OPERATOR: Cities Service Oil; 700 Sutton Pl. Bldg.; 209 E. William; Wichita, Ks. 67202
CONTRACTOR: White & Ellis Drilling, Inc., Box 448, El Dorado, Kansas 67042

Lease Name O'Brien Well No. B-3

Sec. 7 T. 20 R. 21W Spot C/SW SE

County Ness State Kansas Elevation _____

Casing Record:
Surface: 8 5/8" @ 314' with 250 Sxs.
Production: _____ @ _____ with _____ Sxs.

Type Well: D & A Total Depth 4455' KB

Drilling Commenced: 7/20/79 Drilling Completed 7/30/79

Formation	From	To	Tops
Cellar	0	7	Mississippi - 4405
Shale, Lime	7	2457	
Lime	2457	2515	
Lime, Shale	2515	3610	
Lime, Sand	3610	3775	
Lime, Shale	3775	4113	
Lime	4113	4455	

COMPLETION RECORD

Liner Record: Size _____ From _____ To _____

Cementing Record: _____ Sacks _____

Perforating Record: _____

Formation	Perforated Interval	Number Shots

Initial Production: _____

Electric Log _____ Type and Depths Covered _____

