


15-135-20688-0000

STATE OF KANSAS
STATE CORPORATION COMMISSION

Form CP-4

WELL PLUGGING RECORD

Give All Information Completely
Make Required Affidavit
Mail or Deliver Report to:
Conservation Division
State Corporation Commission
P. O. Box 17027
Wichita, Kansas 67217
NORTH

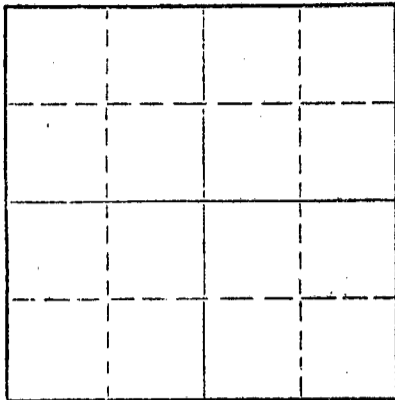

Locate well correctly on above
Section Plat

Ness County, Sec. 17 Twp. 20S Rge. 21W (E) (W) X
Location as "NE/CNW/SW" or footage from lines SE SW
Lease Owner Halliburton Oil Producing Co.
Lease Name Wittman Well No. 1
Office Address 117 Cameron Building, Oklahoma City, Oklahoma
Character of Well (completed as Oil, Gas or Dry Hole) D&A
Date well completed October 16 19 72
Application for plugging filed October 16 19 72
Application for plugging approved October 16 19 72
Plugging commenced October 16 19 72
Plugging completed October 16 19 72
Reason for abandonment of well or producing formation D&A

If a producing well is abandoned, date of last production 19
Was permission obtained from the Conservation Division or its agents before plugging was commenced? Yes

Name of Conservation Agent who supervised plugging of this well Leo F. Massey
Producing formation _____ Depth to top _____ Bottom _____ Total Depth of Well 4465 Feet
Show depth and thickness of all water, oil and gas formations.

OIL, GAS OR WATER RECORDS

CASING RECORD

FORMATION	CONTENT	FROM	TO	SIZE	PUT IN	PULLED OUT
				8-5/8"	344'	-0-

Describe in detail the manner in which the well was plugged, indicating where the mud fluid was placed and the method or methods used in introducing it into the hole. If cement or other plugs were used, state the character of same and depth placed, from _____ feet to _____ feet for each plug set.

Plugged hole w/50 sx @ 600', 25 sx @ 320' - 1/2 sx hulls & plug @ 40' w/10 sx cement to surface. Cement was 50-50 posmix 4% Gel. Plugged by Halliburton.

RECEIVED
STATE CORPORATION COMMISSION
OCT 26 1972
CONSERVATION DIVISION
Wichita, Kansas

(If additional description is necessary, use BACK of this sheet)


Name of Plugging Contractor Red Tiger Drilling Company
Address 1720 Wichita Plaza, Wichita, Kansas 67202

STATE OF Kansas, COUNTY OF Sedgwick, ss.
Virginia K. Albert (employee of owner) or (owner or operator) of the above-described

well, being first duly sworn on oath, says: That I have knowledge of the facts, statements, and matters herein contained and the log of the above described well as filed and that the same are true and correct. So help me God.

(Signature) Virginia K. Albert
1720 Wichita Plaza, Wichita, Kansas 67202
(Address)

SUBSCRIBED AND SWORN TO before me this 18th day of October, 19 72

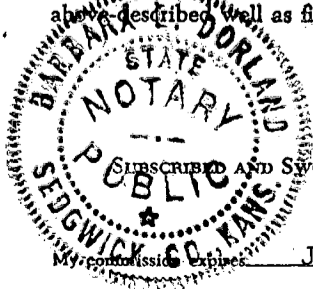

Barbara L. Darland
Notary Public.

DRILLERS LOG

No. 1 Wittman

CASING RECORD:	COMPANY:	Halliburton Oil Producing Co.	DESCRIPTION:
8-5/8" @ 344' w/225 sx cement	CONTRACTOR:	Red Tiger Drilling Company	SE SW 17-20S-21W Ness County, Kansas
TOTAL DEPTH: 4,465'	COMMENCED:	September 29, 1972	ELEVATION:
	COMPLETED:	October 16, 1972	

<u>FORMATION</u>	<u>FROM</u>	<u>TO</u>	<u>REMARKS</u>
Surface Soil - Clay - Post Rock	0	225	
Clay - Post Rock	225	348	
Shale	348	915	
Sand & Shale	915	1155	
Shale & Redbed	1155	1477	
Anhydrite	1477	1511	
Shale	1511	1990	
Shale & Lime	1990	2452	
Lime	2452	2597	
Lime & Shale	2597	2773	
Lime	2773	4465	

RECEIVED
STATE CORPORATION COMMISSION
OCT 26 1972
CONSERVATION DIVISION
Wichita, Kansas

I certify that this is a true and correct copy of the above log to the best of my knowledge.

RED TIGER DRILLING COMPANY

Virginia K. Albert
Virginia K. Albert

Subscribed and sworn to before me this 18th day of October, 1972.

Barbara L. Dorsland
Notary Public

My commission expires:
July 25, 1976

