


15-135-21060-0000

STATE OF KANSAS
STATE CORPORATION COMMISSION
CONSERVATION DIVISION
P. O. BOX 17027
WICHITA, KANSAS 67217

FORM CP-4

WELL PLUGGING RECORD

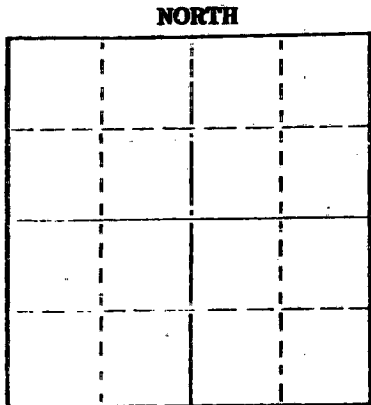

Locate well correctly on above Section Plat

Ness County, Sec 36 Twp 17S Rge (E) 26W (W)
Location as "NE/CNWSW" or footage from lines 150' SW of NW NW
Lease Owner PICKRELL DRILLING COMPANY
Lease Name Norton P Well No. 1
Office Address 705 4th National Bk Bldg. Wichita, Ks. 67202
Character of Well (completed as Oil, Gas or Dry Hole) Dry Hole
Date well completed 6-7- 19 75
Application for plugging filed 6-7 19 75
Application for plugging approved 6-7 19 75
Plugging commenced 6-7 19 75
Plugging completed 6-7 19 75
Reason for abandonment of well or producing formation Dry Hole

If a producing well is abandoned, date of last production 19
Was permission obtained from the Conservation Division or its agents before plugging was commenced? Yes

Name of Conservation Agent who supervised plugging of this well Leo F. Massey
Producing formation _____ Depth to top _____ Bottom _____ Total Depth of Well 4420
Show depth and thickness of all water, oil and gas formations.

OIL, GAS OR WATER RECORDS

CASING RECORD

FORMATION	CONTENT	FROM	TO	SIZE	PUT IN	PULLED OUT
				8 5/8	216	None

Describe in detail the manner in which the well was plugged, indicating where the mud fluid was placed and the method or methods used in introducing it into the hole. If cement or other plugs were used, state the character of same and depth placed, from _____ feet to _____ feet for each plug set.

70 sacks at 720'
20 sacks at 215'
10 sacks at 40' Completed @ 3:30AM 6-7-75

(If additional description is necessary, use BACK of this sheet)

Name of Plugging Contractor Pickrell Drilling Company
Address 705 4th National Bank Bldg. Wichita, Ks. 67202

STATE OF Kansas COUNTY OF Sedgwick
C.W. Sebitts (employee of owner) or (owner or operator) of the above-described well, being first duly sworn on oath, says: That I have knowledge of the facts, statements, and matters herein contained and the log of the above-described well as filed and that the same are true and correct. So help me God.

(Signature) C.W. Sebitts
705 4th National Bk Bldg. Wichita, Ks. 67202
(Address)

Subscribed and sworn to before me this 12 day of June 19 75

My commission expires August 19, 1975

Helen L. Martin
Notary Public.

HELEN L. MARTIN
NOTARY PUBLIC
Sedgwick County, Kans.
My Comm. Expires Aug. 19, 1975

RECEIVED
CONSERVATION DIVISION
JUN 16 1975

15-135-21060-0000
ROTARY DRILLING LOG

COMPANY: PICKRELL DRILLING COMPANY
705 4th National Bk Bldg.
Wichita, Ks. 67202

LOCATION: Norton P #1
150' SW of NW NW 36-17S-26W
Ness County, Kansas

CONTRACTOR: PICKRELL DRILLING COMPANY
Wichita, Kansas

Rotary Drilling Commenced 5-27-75
Rotary Drilling Completed 6-7-75

CASING RECORD: 8 5/8 surface casing set at 216 with 150 sacks cement. Date comp. 5-27-75.

LOG

(Figures indicate bottom of formation — measurements from top of rotary bushing.)

Top Soil & Clay	25
Sand	40
Post Rock	55
Shale	219
Shale	805
Shale	1265
Sand	1480
Shale	1550
Shale	1750
Anhy	1780
Shale	1955
Shale	2320
Shale & Lime	2360
Shale & Lime	2515
Lime	2690
Lime & Shale	2835
Shale & Lime	2965
Lime & Shale	3115
Shale & Lime	3270
Shale & Lime	3420
Lime & Shale	3580
Lime & Shale	3740
Lime & Shale	3850
Lime	3920
Lime	4000
Lime & Shale	4085
Lime & Shale	4137
Lime & Shale	4185
Lime & Shale	4200
Lime	4225
Lime	4280
Lime	4300
Lime	4305
Lime	4349
Lime	4385
Lime	4393
Lime & Chert	4420

RECEIVED
JUN 16 1975

The undersigned, C.W. Sebitts, Attorney-in-Fact for PICKRELL DRILLING COMPANY, hereby certifies in behalf of said Company, that the above is a true and correct log of the formation encountered in drilling the above well as reflected by the Daily Drilling Reports.

PICKRELL DRILLING COMPANY
By [Signature]
Attorney-in-Fact
C.W. Sebitts

STATE OF KANSAS }
COUNTY OF SEDGWICK } ss.:

On this 12 day of June, 19 75, before me the undersigned, a Notary Public, in and for the County and State aforesaid, personally appeared C.W. Sebitts, to me known to be the identical person who subscribed the name of PICKRELL DRILLING COMPANY to the foregoing instrument as its Attorney-in-Fact and acknowledged to me that he executed the same as his free and voluntary act and deed, and as the free and voluntary act and deed of such company, for the uses and purposes therein set forth.

Given under my hand and seal of office the day and year last above written.

My commission expires: August 19, 1975

[Signature]
Notary Public
Helen L. Martin