

STATE CORPORATION COMMISSION OF KANSAS
OIL & GAS CONSERVATION DIVISION
WELL COMPLETION OR RECOMPLETION FORM
ACO-1 WELL HISTORY
DESCRIPTION OF WELL AND LEASE

Operator: License # 4959
Name ZPC Petroleum, Inc.
Address 9319 East Harry, Suite 122
Wichita, Kansas 67207

Purchaser

Operator Contact Person Mr. Zeb Stewart
Phone 316-683-8838

Contractor: License # 5302
Name Red Tiger Drilling Company

Wellsite Geologist Jon B. (Zeh) Stewart
Phone (316) 688-1784

Designate Type of Completion

New Well Re-Entry Workover
 Oil SWD Temp Abd
 Gas Inj Delayed Comp.
 Dry Other (Core, Water Supply etc.)

If OWWO: old well info as follows:

Operator
Well Name
Comp. Date
Old Total Depth

WELL HISTORY

Drilling Method:

Mud Rotary Air Rotary Cable

12/21/87 1/1/88 1/2/88
Spud Date Date Reached TD Completion Date

4,650'
Total Depth PBTD

Amount of Surface Pipe Set and Cemented at 242 feet
Multiple Stage Cementing Collar Used? Yes No
If yes, show depth set...feet
If alternate 2 completion, cement circulated from 2020' feet depth to surf...w/.195 SX cmt
Cement Company Name na/turnkey.w/. Red Tiger.
Invoice #

API NO. 15-135-23,203-0000
County Ness
SE/4 NE/4 NW/4 16 18S 26W East
Sec. Twp. Rge. X West

4290
2970
Ft North from Southeast Corner of Section
Ft West from Southeast Corner of Section
(Note: Locate well in section plat below)


Lease Name Breit Well # 1-16

Field Name

Producing Formation

Elevation: Ground 2635' NB 2640'

Section Plat

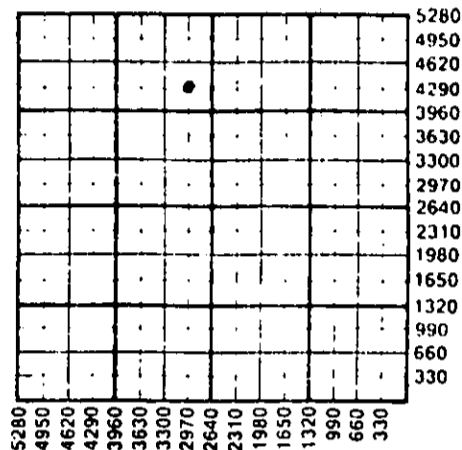

WATER SUPPLY INFORMATION

Disposition of Produced Water: Disposal
Docket # Repressuring

Questions on this portion of the ACO-1 call:

Water Resources Board (913) 296-3717

Source of Water:
Division of Water Resources Permit #

Groundwater Ft North from Southeast Corner (Well) Ft West from Southeast Corner of Sec Twp Rge East West

X Surface Water 4900 Ft North from Southeast Corner (Stream, pond etc) 2300 Ft West from Southeast Corner Sec 8 Twp 18S Rge 26 East X West

Clarence Whipple, Beeler, Ks. 67518

Other (explain)
(purchased from city, R.W.D. #)

INSTRUCTIONS: This form shall be completed in triplicate and filed with the Kansas Corporation Commission, 200 Colorado Derby Building, Wichita, Kansas 67202, within 120 days of the spud date of any well. Rule 82-3-130, 82-3-107 and 82-3-106 apply. Information on side two of this form will be held confidential for a period of 12 months if requested in writing and submitted with the form. See rule 82-3-107 for confidentiality in excess of 12 months. One copy of all wireline logs and drillers time log shall be attached with this form. Submit CP-4 form with all plugged wells. Submit CP-111 form with all temporarily abandoned wells.

1-21-88

All requirements of the statutes, rules and regulations promulgated to regulate the oil and gas industry have been fully complied with and the statements herein are complete and correct to the best of my knowledge.

Signature Jon R. Stewart
Title Resident Date 1-13-88

Subscribed and sworn to before me this 13th day of January 1988

Notary Public

Date Commission Expires 10/19/91

K.C.C. OFFICE USE ONLY
Letter of Confidentiality Attached
Wireline Log Received
Drillers Timelog Received
Distribution: KCC SWD/Rep NGPA, KGS Plug Other (Specify)

Operator Name ZPC Petroleum, Inc. Lease Name Breit Well # 1-16

Sec. 16 Twp. 18S Rge. 26W East West County Ness

WELL LOG

INSTRUCTIONS: Show important tops and base of formations penetrated. Detail all cores. Report all drill stem tests giving interval tested, time tool open and closed, flowing and shut-in pressures, whether shut-in pressure reached static level, hydrostatic pressures, bottom hole temperature, fluid recovery, and flow rates if gas to surface during test. Attach extra sheet if more space is needed. Attach copy of log.

Drill Stem Tests Taken [X] Yes [] No
Samples Sent to Geological Survey [] Yes [X] No
Cores Taken [] Yes [X] No

Formation Description [X] Log [] Sample

DST #1: 4568-98 (Cherokee Sandstone)
30-60-30-30
2' of Oil Specked Mud
ISIP:34# FSIP:27# IFP:20-20#FFP:22-22#
IHP:2298# FHP:2287#
BHT: 119°F
DST #2: 30-60-60-90 (Mississippian)
4615-50
1,090 Very slightly oil specked muddy water.
ISIP:1251# FSIP:1232# IFP:57-198#
FFP:244-456# IHP:2476# FHP:2356#
BHT: 125°F

Table with 3 columns: Name, Top, Bottom. Rows include Anhydrite, Heebner, Lansing, B/KC, Ft. Scott, Mississippian, RTD.

RELEASED

FEB 15 1989

FROM CONFIDENTIAL

CASING RECORD, PERFORATION RECORD, TUBING RECORD, Date of First Production, Producing Method, Estimated Production Per 24 Hours

METHOD OF COMPLETION

Production Interval

Disposition of gas: [] Vented [] Open Hole [] Perforation
[] Sold [] Other (Specify)
[] Used on Lease [] Dually Completed [] Commingled