


STATE OF KANSAS
STATE CORPORATION COMMISSION

Give All Information Completely
Make Required Affidavit
Mail or Deliver Report to:
Conservation Division
State Corporation Commission
212 North Market, Insurance Bldg.
Wichita, Kansas

WELL PLUGGING RECORD

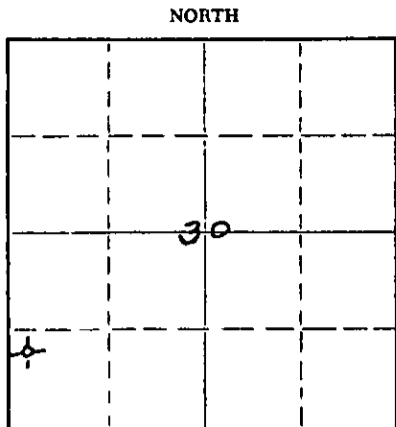

Locate well correctly on above
Section Plat

Rush County, Sec. 30 Twp. 16S Rge. 20 (X) W (W)
Location as "NE/CNWSW" or footage from lines. NW SW SW
Lease Owner D. R. Lauck Oil Company, Inc.
Lease Name Irvin Well No. 2
Office Address 301 South Broadway, Wichita, Kansas
Character of Well (completed as Oil, Gas or Dry Hole) dry hole
Date well completed October 11 1960
Application for plugging filed October 11 1960
Application for plugging approved October 11 1960
Plugging commenced October 11 1960
Plugging completed October 11 1960

Reason for abandonment of well or producing formation dry hole
If a producing well is abandoned, date of last production 19
Was permission obtained from the Conservation Division or its agents before plugging was commenced? yes

Name of Conservation Agent who supervised plugging of this well Mr. Eldon Petty
Producing formation _____ Depth to top _____ Bottom _____ Total Depth of Well 4126 Feet
Show depth and thickness of all water, oil and gas formations.

OIL, GAS OR WATER RECORDS

CASING RECORD

FORMATION	CONTENT	FROM	TO	SIZE	PUT IN	PULLED OUT
		0	273	8 5/8	273	none

Describe in detail the manner in which the well was plugged, indicating where the mud fluid was placed and the method or methods used in introducing it into the hole. If cement or other plugs were used, state the character of same and depth placed, from _____ feet to _____ feet for each plug set.

hole filed with mud 4126-550
plug 550-546
mud 20 sacks cement 546-180
plug 180-176
mud 176-35
plug 35-31
10 sacks cement 31-6 bottom of cellar

RECEIVED
STATE CORPORATION COMMISSION
OCT 21 1960
CONSERVATION DIVISION
Wichita, Kansas

(If additional description is necessary, use BACK of this sheet)
Name of Plugging Contractor Globe Cementing Co.
Address Great Bend, Kansas

STATE OF Kansas, COUNTY OF Sedgwick, ss.
John H. Knightley (employee of owner) or (owner or operator) of the above-described well, being first duly sworn on oath, says: That I have knowledge of the facts, statements, and matters herein contained and the log of the above-described well as filed and that the same are true and correct. So help me God.

(Signature) John H. Knightley
(Address) _____

SUBSCRIBED AND SWORN TO before me this 20 day of October, 1960

Helen Stanley
Notary Public.

My commission expires September 4, 1960

15-165-01849-0008

D. R. Lauck

Irvin #1

NW NW SW 30-16S-20W
Rush County, Kansas

Commenced: September 18, 1960
Completed: September 29, 1960

Casing Record: 262' 8 5/8" cemented with 195 sacks
calcium chloride 4 sacks

Elevation: GR 2172; DF 2174; KB 2176

Drillers Log

Tops

Welex

Surface Clay	45
Shale	160
Blue Shale	262
Shale	715
Sand	730
Shale & Shells	870
Sand	985
Red Bed & Shale	1465
Anhydrite	1490
Red Bed & Shale	1800
Shale & Clay	2110
Shale & Shells	2150
Anhydrite	2255
Lime & Shale	2520
Shale & Lime	2580
Lime & Shale	2750
Shale & Chalky Lime	2790
Shale & Shells	3035
Shale & Lime	3425
Lime & Shale	3668
Heebner	3571
Lime & Shale	3600
Lime	3655
Lime & Shale	3705
Lime	3905
Lime & Shale	3935
Lime	4014
Shale	4031
Sand	4070
Shale & Lime	4104
Arbuckle	4135 RTD

Heebner	3566-1390
Toronto	3586-1410
Lansing-Kansas City	3613-1437
Base Kansas City	3876-1700
Cherokee Shale	4014-1838
Cherokee Sand	4032-1856
Arbuckle	4092-1916
Rotary Total Depth	4136-1960

DST #1 (M) 4014-4037 Open 1 hour; strong
blow 1 hour, Recovered 1800' salt
water
ISIP 1205# 20 minutes
F'SIP 1050# 20 minutes
I'P 255# F'P 850# D&A

RECEIVED
STATE CORPORATION COMMISSION
CONSERVATION DIVISION
Wichita, Kansas