


15-165-28445-0000

STATE OF KANSAS  
CORPORATION COMMISSION

Give All Information Completely  
Make Required Affidavit  
Mail or Deliver Report to:  
Conservation Division  
State Corporation Commission  
212 North Market, Insurance Bldg.  
Wichita, Kansas

WELL PLUGGING RECORD

NORTH

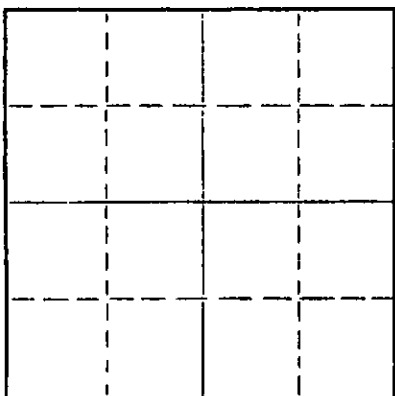

Locate well correctly on above  
Section Plat

RUSH County. Sec. 23 Twp. 16S Rge. 20W (E) (W)  
Location as "NE/CNW/SW" or footage from lines NE NE SE  
Lease Owner John O. Farmer, Inc.  
Lease Name OEKKERS Well No. 1  
Office Address Box 352, Russell, Kansas 67665  
Character of Well (completed as Oil, Gas or Dry Hole) Dry Hole  
Date well completed 8/25 1972  
Application for plugging filed 8/25 1972  
Application for plugging approved 8/25 1972  
Plugging commenced 8/25 1972  
Plugging completed 10:30 a.m. 8/25 1972  
Reason for abandonment of well or producing formation

If a producing well is abandoned, date of last production 19  
Was permission obtained from the Conservation Division or its agents before plugging was commenced? Yes

Name of Conservation Agent who supervised plugging of this well Leo Massey, Hays, Kansas  
Producing formation Depth to top Bottom Total Depth of Well 3895 Feet  
Show depth and thickness of all water, oil and gas formations.

OIL, GAS OR WATER RECORDS

CASING RECORD

FORMATION	CONTENT	FROM	TO	SIZE	PUT IN	PULLED OUT

Describe in detail the manner in which the well was plugged, indicating where the mud fluid was placed and the method or methods used in introducing it into the hole. If cement or other plugs were used, state the character of same and depth placed, from feet to feet for each plug set.

Plug # 1 600' 70 sx. cement  
Plug # 2 215' 20 sx. cement  
Plug # 3 40' 10 sx. cement  
Completed: 10:30 am 8/25/72  
Leo Massey, State Plugger

RECEIVED  
STATE CORPORATION COMMISSION  
AUG 30 1972  
CONSERVATION DIVISION  
Wichita, Kansas

(If additional description is necessary, use BACK of this sheet)

Name of Plugging Contractor John O. Farmer, Inc.  
Address P.O. Box 352, Russell, Kansas 67665

STATE OF KANSAS, COUNTY OF RUSSELL, ss.  
JOHN O. FARMER, president (employee of owner) or (owner or operator) of the above-described well, being first duly sworn on oath, says: That I have knowledge of the facts, statements, and matters herein contained and the log of the above-described well as filed and that the same are true and correct. So help me God.

(Signature) John O. Farmer  
P.O. Box 352, Russell, Kansas 67665  
(Address)

Subscribed and sworn to before me this 28th day of August, 1972


My commission expires February 15, 1975

Helen Carlson Notary Public.

OPERATOR John O. Farmer, Inc.

ADDRESS Box 352, Russell, Kansas

640 Acres  
N

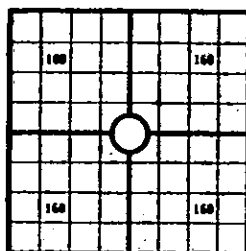

Locate well correctly

COUNTY Rush, SEC. 23, TWP. 16S, RGE. 20W  
COMPANY OPERATING John O. Farmer, Inc.  
OFFICE ADDRESS Box 352, Russell, Ks.  
DRILLING STARTED 8/15, 1972, DRILLING FINISHED 8/25, 1972  
DATE OF FIRST PRODUCTION \_\_\_\_\_ COMPLETED \_\_\_\_\_  
WELL LOCATED NE 1/4 NE 1/4 SE 1/4, North of South  
Line and \_\_\_\_\_ ft. East of West Line of Quarter Section  
Elevation (Relative to sea level) DERRICK FLOOR 2133 BOUNDARY 2135  
CHARACTER OF WELL (Oil, gas or dryhole) Dryhole

OIL OR GAS SANDS OR ZONES

Name	From	To	Name	From	To
1			4		
2			5		
3			6		

Perforating Record If Any

Shot Record

Formation	From	To	No. of Shots	Formation	From	To	Size of Shot

CASING RECORD

Amount Set								Amount Pulled		Packer Record	
Size	Wt.	Thds.	Make	Ft.	In.	Ft.	In.	Size	Length	Depth Set	Make

Liner Record: Amount \_\_\_\_\_ Kind \_\_\_\_\_ Top \_\_\_\_\_ Bottom \_\_\_\_\_

CEMENTING AND MUDDING

Size	Amount Set Ft. In.	Sacks Cement	Chemical Gal. Make	Method of Cementing	Amount	Mudding Method	Results (See Note)
8-5/8"	229'	150	sx cement				

Note: What method was used to protect sands if outer strings were pulled?

NOTE: Were bottom hole plugs used? If so, state kind, depth set and results obtained

TOOLS USED

Rotary Tools were used from 0 feet to R.T.D. Cable tools were used from \_\_\_\_\_ feet to \_\_\_\_\_ feet, and from \_\_\_\_\_ feet to \_\_\_\_\_ feet, and from \_\_\_\_\_ feet to \_\_\_\_\_ feet  
Type Rig Rotary

INITIAL PRODUCTION TEST

Describe initial test: whether by flow through tubing or casing or by pumping

Amount of Oil Production \_\_\_\_\_ bbls. Size of choke, if any \_\_\_\_\_ Length of test \_\_\_\_\_ Water  
Production \_\_\_\_\_ bbls. Gravity of oil \_\_\_\_\_ Type of Pump if pump is used, describe \_\_\_\_\_

FORMATION RECORD

Give detailed description and thickness of all formation drilled through, contents of sand, whether dry, water, oil or gas.

Formation	XXXXXX	Formation	Top	Bottom
Log Tops				
Anhydrite	1374			
Topoka	3155			
Heebner	3446			
Toronto	3465			
Lansing	3490			
B/Kansas City	3748			
Marmaton	3809			
Arbuckle	3854			
Log T.D.	3888			
Rotary T.D.	3895			
		Shale	230	775
		Sand	775	1040
		Redbed	1040	1373
		Anhydrite	1373	1410
		Shale shells	1410	2235
		Shale lime	2235	2410
		Lime	2410	2610
		Lime shale	2610	3510
		Lime	3510	3895

RECEIVED  
STATE CORPORATION COMMISSION  
OCT 30 1972  
CONSERVATION DIVISION  
Wichita, Kansas

I, the undersigned, being first duly sworn upon oath, state that this well record is true, correct and complete according to the records of this office and to the best of my knowledge and belief.

John O. Farmer  
Name and title of representative of company  
President  
Subscribed and sworn to before me this 28th day of August, 1972  
My Commission expires 2/15/75  
Helen Carlson  
Notary Public

15-16-2045-0000