


STATE OF KANSAS  
STATE CORPORATION COMMISSION  
CONSERVATION DIVISION  
P. O. BOX 17027  
WICHITA, KANSAS 67217

WELL PLUGGING RECORD

Rush County. Sec. 23 Twp. 16<sup>S</sup> Rge. 20W (E) (W)  
Location as "NE/CNW/SE" or footage from lines. SE NE SE  
Lease Owner Easy Drilling Company  
Lease Name Hutchings Well No. 1  
Office Address 411 East 15th ST. Hays, Kansas  
Character of Well (completed as Oil, Gas or Dry Hole) Dry Hole  
Date well completed 11-20 1978  
Application for plugging filed 12-23 1978  
Application for plugging approved 12-23 1978  
Plugging commenced 12-23 1978  
Plugging completed 10:30 A.M. 12-23 1978  
Reason for abandonment of well or producing formation \_\_\_\_\_

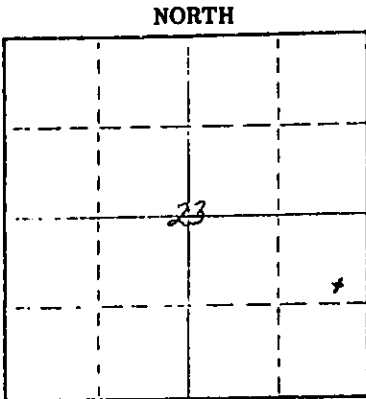

Locate well correctly on above Section Plot

If a producing well is abandoned, date of last production \_\_\_\_\_ 19\_\_\_\_  
Was permission obtained from the Conservation Division or its agents before plugging was commenced? yes

Name of Conservation Agent who supervised plugging of this well Leo Massey Hays, Kansas  
Producing formation \_\_\_\_\_ Depth to top \_\_\_\_\_ Bottom \_\_\_\_\_ Total Depth of Well 3889KB  
Show depth and thickness of all water, oil and gas formations.

OIL, GAS OR WATER RECORDS

CASING RECORD

FORMATION	CONTENT	FROM	TO	SIZE	PUT IN	PULLED OUT

Describe in detail the manner in which the well was plugged, indicating where the mud fluid was placed and the method or methods used in introducing it into the hole. If cement or other plugs were used, state the character of same and depth placed, from \_\_\_\_\_ feet to \_\_\_\_\_ feet for each plug set.

Plug 645  
Cement 100-645  
Cement 220-0  
With Gel in Between

RECEIVED  
STATE CORPORATION COMMISSION  
JAN 11 1979  
CONSERVATION DIVISION  
Wichita, Kansas

(If additional description is necessary, use BACK of this sheet)  
Name of Plugging Contractor Company Tools by Halliburton  
Address Hays, Kansas

STATE OF Kansas COUNTY OF Rush 59.  
Gene Legleiter (employee of owner) or (owner) operator of the above-described well, being first duly sworn on oath, says: That I have knowledge of the facts, statements, and matters herein contained and the log of the above-described well as filed and that the same are true and correct. So help me God.

(Signature) Gene Legleiter  
411 E 15th ST, Hays, Ks  
(Address)

Subscribed and sworn to before me this 4 day of JANUARY, 1979  
Marvin Schumacher  
Notary Public.

My commission expires May 9, 1980

# WOODMAN & IANNITTI DRILLING COMPANY

Rotary Drilling Contractors

1008 DOUGLAS BUILDING  
104 S. BROADWAY  
WICHITA, KANSAS 67202

November 27, 1978

Company;	Easy Drilling Co.
Farm;	#1 Hutchings
Location;	SE NE SE
Section;	23-16-20W
County;	Rush
Contractor;	Woodman & Iannitti Drilling Co.
Comm;	November 12, 1978
Compl;	November 20, 1978
Total Depth;	3889'
Casing;	8 5/8" @ 221' w/165 sx. cap hole w/8 5/8 plug & 2" plug valve hole is to be used for disposal well

Figures Indicate Bottom Of Formations:

40	Surface soil & shale
222	Shale
690	Shale
722	Shale
770	Shale & sand
1042	Dakoto sand
1345	Red bed
1373	Shale
1409	Anhy
1724	Red bed & shale
2375	Shale
2916	Lime & shale
3347	Lime & shale
3540	Lime
3750	Lime
3879	Lime
3889	Arbuckle

RECEIVED  
STATE CORPORATION COMMISSION  
JAN 11 1979  
CONSERVATION DIVISION  
Wichita, Kansas

I certify the above to be a true and correct copy of the driller's log to the best of my knowledge and belief.

Woodman & Iannitti Drilling Co.

*K. T. Woodman -gc*  
K. T. Woodman