


STATE OF KANSAS
STATE CORPORATION COMMISSION

WELL PLUGGING RECORD

Give All Information Completely
Take Required Affidavit
Well or Beliver Report to
Conservation Division
State Corporation Comm.
245 North Water
Wichita, KS 67202

Rush County, Sec. 23 Twp. 16S Rge. 20 X/W
Location as "NE/CNW/SW" or footage from lines
E/2 NE/4 NE/4

Lease Owner F & M Oil Co., Inc.
Lease Name Myers Well No. 1
Office Address 422 Union Center, Wichita, KS 67202
Character of Well (Completed as Oil, Gas or Dry Hole)
dry hole

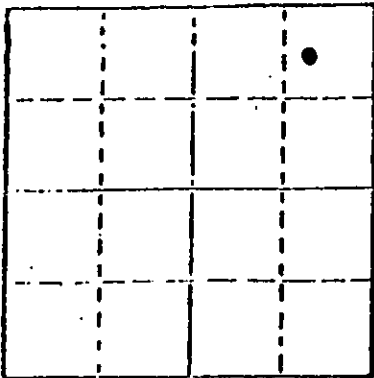

Locate well correctly on above
Section Plot

Date Well completed 6/06 19 81
Application for plugging filed 6/06 19 81
Application for plugging approved 6/06 19 81
Plugging commenced 6/06 19 81
Plugging completed 6/06 19 81

Reason for abandonment of well or producing formation
No commercial quantity of oil or gas encountered.
If a producing well is abandoned, date of last production
19

Was permission obtained from the Conservation Division or
its agents before plugging was commenced? yes

Name of Conservation Agent who supervised plugging of this well Marion Schmidt
Producing formation _____ Depth to top _____ Bottom _____ Total Depth of Well _____
Show depth and thickness of all water, oil and gas formations.

OIL, GAS OR WATER RECORDS

CASING RECORD

FORMATION	CONTENT	FROM	TO	SIZE	PUT IN	PULLED OUT

Describe in detail the manner in which the well was plugged, indicating where the mud fluid
was placed and the method or methods used in introducing it into the hold. If cement or other
plugs were used, state the character of same and depth placed, from _____ feet to
_____ feet for each plug set.

T.D. 3880'. Set first plug at 740 feet with 65 sacks 50/50 pos., 6% Gel,
second plug at 300 feet with 30 sacks, 10 sacks and bridge at 40 feet
and 5 sacks in rat hole. Cement by Dowell. Job completed at 10:00 A.M.
on 6/06/81. State Plugger - Marion Schmidt

(If additional description is necessary, use BACK of this sheet)

Name of Plugging Contractor KAW Drilling Co., Inc.


STATE OF KANSAS COUNTY OF SEDGWICK, ss.
K.S. Martin, President of KAW Drilling Co., Inc. (~~operator~~ operator)
of the above-described well, being first duly sworn on oath, says: That I have knowledge of
the facts, statements, and matters herein contained and the log of the above-described well
as filed and that the same are true and correct. So help me God.

(Signature) [Signature]
K.S. Martin, President, 1010 Union Center
(Address) Wichita, KS 67202

SUBSCRIBED AND SWORN TO before me this 9th day of June, 1981.

[Signature]
Mary Susan Whaley
Notary Public.

My commission expires December 10, 1983

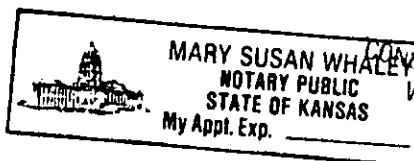

JUN 10 1981

CONSERVATION DIVISION
Wichita, Kansas

OPERATOR:	F & M OIL CO., INC.
CONTRACTOR:	KAW Drilling Co., Inc.
WELL NAME:	MYERS #1
LOCATION:	E/2 NE/4 NE/4 Section 23-16S-20W Rush County, Kansas
SPUD DATE:	May 30, 1981
COMPLETION DATE:	June 6, 1981


0	1773	Shale
1774	2600	Shell & Shale
2601	3639	Shale
3640	3880	Lime & Shale
	3880	R.T.D.

Spud hole at 2:30 P.M. on May 30, 1981. Drilled 284 feet of 12½ inch hole. Ran 7 joints of 8 5/8 inch, 24 pound new surface casing. (Tallied at 272.52 feet) Set casing at 284 feet with 250 sacks of common cement, 2% Gel, 3% C.C. Cement by Allied Cementing. Job completed at 9:00 A.M. on May 31, 1981.


Total Depth 3830 feet. Set first plug at 740 feet with 65 sacks 50/50 pos., 6% Gel, second plug at 300 feet with 30 sacks, 10 sacks and bridge at 40 feet and 5 sacks in rat hole. Cement by Dowell. Job completed at 10:00 A.M. on June 6, 1981. State Plugger was Marion Schmidt.

STATE OF KANSAS)
) ss
COUNTY OF SEDGWICK)


I, K. S. Martin, President of KAW Drilling Co., Inc., being first duly sworn and upon my oath, state that: I have knowledge of the facts, statements and matters herein contained and the log of the above described well as filed and that the same are true and correct. So help me God.

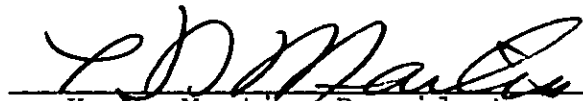
K. S. Martin, President

SUBSCRIBED AND SWORN to before me on this 9th day of June, 1981.

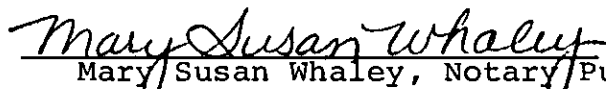
Mary Susan Whaley, Notary Public

My Commission Expires:
December 10, 1983

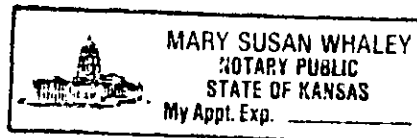

RECEIVED
STATE CORPORATION DIVISION
JUN 10 1981
CONSERVATION DIVISION
Wichita, Kansas