

STATE OF KANSAS
STATE CORPORATION COMMISSION

Give All Information Completely
Make Required Affidavit
Mail or Deliver Report to:
Conservation Division
State Corporation Commission
800 Bittling Building
Wichita, Kansas

WELL PLUGGING RECORD

Rush County, Sec. 1 Twp. 17 Rge. 16 (W)

Location as "NE/CNWxSWx" or footage from lines SW S, SW

Lease Owner: Anschutz Drilling Company

Lease Name: Krug Well No. 1

Office Address: 709 Union National Bank Bldg.

Character of Well (completed as Oil, Gas or Dry Hole) Dry Hole

Date well completed 6/19/53 19 53

Application for plugging filed 6/19 19

Application for plugging approved 6/23 19


Plugging commenced 6/19 19

Plugging completed 6/19 19

Reason for abandonment of well or producing formation

If a producing well is abandoned, date of last production 19

Was permission obtained from the Conservation Division or its agents before plugging was commenced? Yes

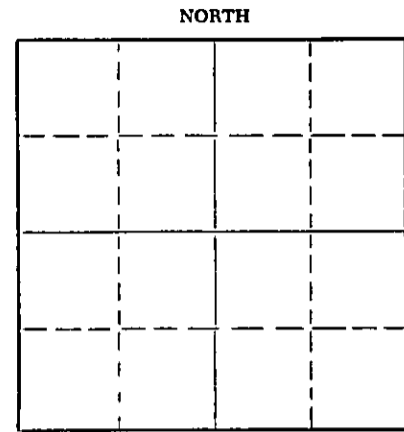

Locate well correctly on above Section Plat

Name of Conservation Agent who supervised plugging of this well C. D. Stough

Producing formation Depth to top Bottom Total Depth of Well 3639 Feet Cor.

Show depth and thickness of all water, oil and gas formations.

OIL, GAS OR WATER RECORDS

CASING RECORD

FORMATION	CONTENT	FROM	TO	SIZE	PUT IN	PULLED OUT
				8-5/8	203'	

Describe in detail the manner in which the well was plugged, indicating where the mud fluid was placed and the method or methods used in introducing it into the hole. If cement or other plugs were used, state the character of same and depth placed, from feet to feet for each plug set.

Filled hole with heavy mud to 200'. Bottom plug set at 200' with 20 sacks cement. Filled up to 35' with mud and 1/2 sack of hulls. Top Plug set at 35' with 10 sacks cement.

(If additional description is necessary, use BACK of this sheet)

Name of Plugging Contractor Bill Hay Drilling Co.

Address Hoisington, Kansas

STATE OF Kansas, COUNTY OF Sedgwick, ss.
Leon L. Mehler (employee of owner) or (owner or operator) of the above-described well, being first duly sworn on oath, says: That I have knowledge of the facts, statements, and matters herein contained and the log of the above-described well as filed and that the same are true and correct. So help me God.


(Signature) *Leon L. Mehler*

709 Union National Bank Bldg., Wichita, Kansas (Address)

SUBSCRIBED AND SWORN TO before me this 8th day of July, 1953

Wilma V. Shipman
Notary Public.

My commission expires May 24, 1956

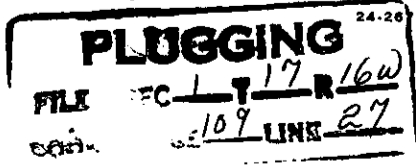

7-9-53

D R I L L E R ' S L O G

Anschutz et al #1 Krug
 SW SW SW Sec. 1-17S-16W
 Rush County, Kansas

<u>FROM</u>	<u>TO</u>	
0	15	Surface
15	38	Clay
38	320	Sand, Shale & Shells
320	430	Shale
430	480	Sand, Shale, Pyrite
480	590	Shale
590	756	Sand
756	1195	Shale and Shells
1195	1245	Anhydrite
1245	1470	Shale and Shells
1470	1680	Red Bed and Shale
1680	1850	Shale and Shells
1850	1905	Ft. Riley
1905	2185	Lime and Shale
2185	2255	Lime and Shale
2255	2355	Brk. Lime
2355	2455	Lime and Shale
2455	2565	Sandy Lime and Shale
2565	2900	Lime and Shale
2900	2978	Shale
2978	3308	Lime
3308	3339	Shale and Lime
3339	3363	K. C. Lime
3363	3587	Lime
3587	3619	Lime and Shale
3619	3642	Arbuckle
3642		T.D.

COMMENCED: 6/8/53

COMPLETED: 6/19/53

CASING RECORD:

8-5/8" surface casing
 set at 203' with 135 sacks
 cement

STATE OF KANSAS)
) SS.
 COUNTY OF SEDGWICK)

I hereby affirm that the above and foregoing is a true and correct copy of the log of the #1 Krug located SW SW SW Sec. 1-17S-16W, Rush County, Kansas.

ANSCHUTZ DRILLING COMPANY

By: Leon L. Mebler
 Leon L. Mebler

Subscribed and sworn to before me this 8th day of July, 1953.

My Comm. Expires: May 24, 1956

Hilma V. Shipman
 Notary Public

RECEIVED
 STATE CORPORATION DIVISION
 JUL 9 1953
 COMMERCE DEPARTMENT
 TOPEKA, KANSAS

PLUGGING
 FILE SEC 17 16W
 BOOK PAGE 109 LINE 27