


STATE OF KANSAS
STATE CORPORATION COMMISSION

Form CP-4

Give All Information Completely
Make Required Affidavit
Mail or Deliver Report to:
Conservation Division
State Corporation Commission
212 No. Market
Wichita, Kansas

WELL PLUGGING RECORD

NORTH

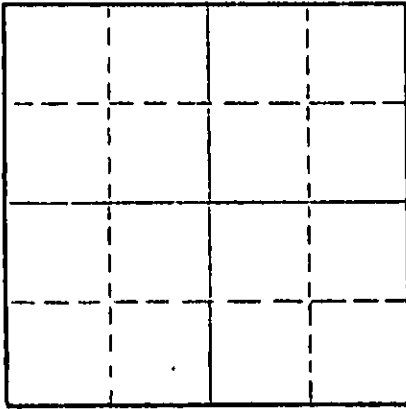

Locate well correctly on above
Section Plat

Ness County. Sec. 12 Twp. 20S Rge. 23 (W)
Location as "NE/CNWSW4" or footage from lines C SE SW
Lease Owner: Pickrell Drilling Company
Lease Name: Ripple "A" Well No. 1
Office Address: 705 4th Nat'l Bank Bldg., Wichita, Kansas 67202
Character of Well (completed as Oil, Gas or Dry Hole) Dry Hole
Date well completed April 14, 1969
Application for plugging filed April 14, 1969
Application for plugging approved April 14, 1969
Plugging commenced April 14, 1969
Plugging completed April 14, 1969
Reason for abandonment of well or producing formation Dry Hole

If a producing well is abandoned, date of last production 19____
Was permission obtained from the Conservation Division or its agents before plugging was commenced? Yes

Name of Conservation Agent who supervised plugging of this well Leo Massey
Producing formation _____ Depth to top _____ Bottom _____ Total Depth of Well 4375' Feet
Show depth and thickness of all water, oil and gas formations.

OIL, GAS OR WATER RECORDS

CASING RECORD

FORMATION	CONTENT	FROM	TO	SIZE	PUT IN	PULLED OUT
				8 5/8"	249'	None

Describe in detail the manner in which the well was plugged, indicating where the mud fluid was placed and the method or methods used in introducing it into the hole. If cement or other plugs were used, state the character of same and depth placed, from _____ feet to _____ feet for each plug set.

Heavy mud to 720'. Set plug. Cemented with 70 sacks cement.

Heavy mud to 240'. Set plug. Cemented with 20 sacks cement.

Heavy mud to 40'. Set plug. Cemented to bottom of cellar with

10 sacks cement. Plugged rat hole with 2 sacks cement.

RECEIVED
STATE CORPORATION COMMISSION
APR 20 1969
CONSERVATION DIVISION
Wichita, Kansas


(If additional description is necessary, use BACK of this sheet)
Name of Plugging Contractor Pickrell Drilling Company
Address 705 Fourth National Bank Bldg., Wichita, Kansas 67202

STATE OF Kansas, COUNTY OF Sedgwick ss.
C. W. Sebitts (owner or operator) of the above-described

do hereby sworn on oath, says: That I have knowledge of the facts, statements and matters herein contained and the log of the well as filed and that the same are true and correct. So help me God.

(Signature) C. W. Sebitts, Partner & Attorney-in-Fact
705 4th Nat'l Bank Bldg., Wichita, Ks. 67202
(Address)

sworn to before me this 22nd day of April, 1969

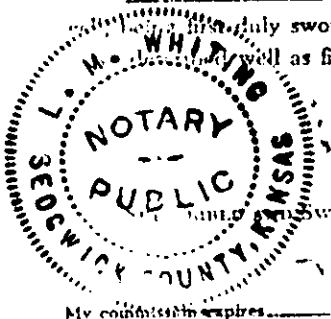

L. M. Whiting
Notary Public.

My commission expires May 10, 1970

ROTARY DRILLING LOG

COMPANY: Pickrell Drilling Company
705 Fourth National Bank Bldg.
Wichita, Kansas 67202

Rotary Drilling Commenced 4/2/69

Rotary Drilling Completed 4/14/69

LOCATION: Ripple "A" No. 1
C SE SW Section 12-20S-23W
Ness County, Kansas

CONTRACTOR: **PICKRELL DRILLING COMPANY**
Wichita, Kansas

CASING RECORD: (13 jts.) Used 28# 8 5/8" surface casing set at 249' KB and cemented with 160 sacks cement. Complete 3:15 PM, 4/2/69. Circulated.

No oil string was run. D. & A., plugged 4/14/69.

LOG

(Figures indicate bottom of formation — measurements from top of rotary bushing.)

RECEIVED
STATE CORPORATION COMMISSION
APR 29 1969
CONSERVATION DIVISION
Wichita, Kansas

135	Clay & Post Rock	C. F. S.
249	Blue Shale & Cement	<u>4257'</u>
645	Shale & Shells & Clay	4268'
890	Red Bed & Shale	4290'
1100	Shale & Sand, Shells	4335'
1431	Shale & Sand Stringers	4342'
1468	Anhydrite	4350'
1650	Shale	4355'
2115	Shale & Lime	4360'
2533	Lime & Shale	4365'
2540	Shale & Lime	4370'
2675	Lime & Shale	4375'
2955	Shale & Lime	
3125	Shale	
3410	Shale & Sandy Lime	Slope Tests
3551	Shale & Lime	<u>2500'</u>
3575	Shale	3000'
3760	Sandy Lime & Shale	3500'
3920	Lime	4000'
4257	Lime & Shale	
4290	Sand, Shale & Lime	
4320	Lime	S. L. M.
4350	Lime & Shale	
4360	Lime, Shale & Chert	Board 4305.09'
4375	Mississippi, RTD	Strap 4304.42'
		Diff. .67'

The undersigned, C. W. Sebitts, Attorney-in-Fact for PICKRELL DRILLING COMPANY, hereby certifies in behalf of said Company, that the above is a true and correct log of the formation encountered in drilling the above well as reflected by the Daily Drilling Reports.

PICKRELL DRILLING COMPANY

By [Signature]
C. W. Sebitts, Attorney-in-Fact

STATE OF KANSAS }
COUNTY OF SEDGWICK } ss.:

On this 22nd day of April, 1969, before me the undersigned, a Notary Public, in and for the County and State aforesaid, personally appeared C. W. Sebitts, to me known to be the identical person who subscribed the name of PICKRELL DRILLING COMPANY to the foregoing instrument as its Attorney-in-Fact and acknowledged to me that he executed the same as his free and voluntary act and deed, and as the free and voluntary act and deed of such company, for the uses and purposes therein set forth.

My commission expires: May 10, 1970

[Signature]
Notary Public
L. M. WHITING

