


STATE OF KANSAS  
STATE CORPORATION COMMISSION

Give All Information Completely  
Make Required Affidavit  
Mail or Deliver Report to:  
Conservation Division  
State Corporation Commission  
212 No. Market  
Wichita, Kansas

WELL PLUGGING RECORD

Ness County, Sec. 19 Twp. 20S Rge. (E) 23 (W)

Location as "NE/CNWxSWx" or footage from lines C/NW SW  
Lease Owner R. V. Lehner  
Lease Name Strobel Well No. 2  
Office Address P. O. Box 398, Ness City, Kansas 67560  
Character of Well (completed as Oil, Gas or Dry Hole) Dry Hole  
Date well completed October 4 19 69  
Application for plugging filed October 4 19 69  
Application for plugging approved October 4 19 69  
Plugging commenced October 4 19 69  
Plugging completed October 4 19 69  
Reason for abandonment of well or producing formation Dry Hole

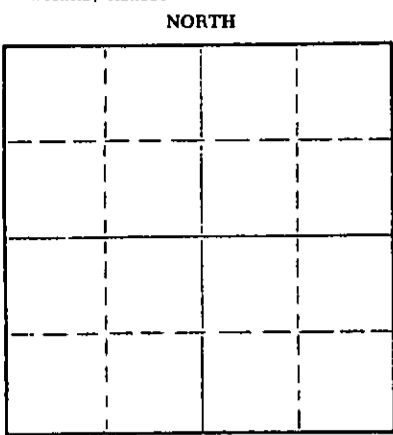

Locate well correctly on above Section Plat

If a producing well is abandoned, date of last production 19  
Was permission obtained from the Conservation Division or its agents before plugging was commenced? Yes

Name of Conservation Agent who supervised plugging of this well Leo Massey, Hays, Kansas  
Producing formation Depth to top Bottom Total Depth of Well 4398 Feet  
Show depth and thickness of all water, oil and gas formations.


OIL, GAS OR WATER RECORDS

CASING RECORD

FORMATION	CONTENT	FROM	TO	SIZE	PUT IN	PULLED OUT
	8-5/8"	0	288.42'			

Describe in detail the manner in which the well was plugged, indicating where the mud fluid was placed and the method or methods used in introducing it into the hole. If cement or other plugs were used, state the character of same and depth placed, from feet to feet for each plug set.

Plugged hole as follows: Plugged at 650' with 70 sacks of cement; plugged at 270' with 30 sacks of cement; plugged at 40' with 10 sacks of cement. Plug down at 10:30 A. M. October 4, 1969.

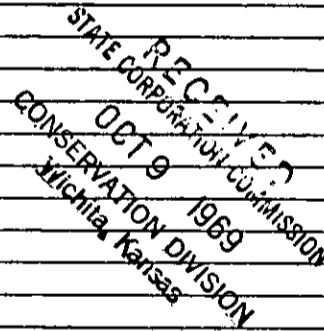


(If additional description is necessary, use BACK of this sheet)

Name of Plugging Contractor Strata Drilling, Inc.  
Address P. O. Box 355, Great Bend, Kansas 67530

STATE OF KANSAS, COUNTY OF BARTON, ss.  
Charles W. Steincamp (employee of owner) or (owner) of the above-described well, being first duly sworn on oath, says: That I have knowledge of the facts, statements, and matters herein contained and the log of the above-described well as filed and that the same are true and correct. So help me, God.

(Signature) Charles W. Steincamp  
Charles W. Steincamp, President  
P. O. Box 355, Great Bend, Kansas 67530  
(Address)

Subscribed AND SWORN TO before me this 6th day of October, 19 69  
December 14, 1969

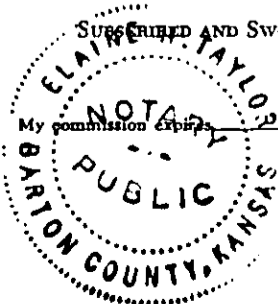

Elaine H. Taylor Notary Public

D R I L L E R S    L O G

#2 Strobel

CASING RECORD:  
288.42' of new 8-5/8"  
surface casing.

COMPANY: R. V. Lehner  
CONTRACTOR: Strata Drilling, Inc.

DESCRIPTION: C/NW SW  
Section 19-20S-23W  
Ness County, Kansas

TOTAL DEPTH:  
4398'

COMMENCED: September 24, 1969  
COMPLETED: October 4, 1969

ELEVATION: 2295' KB

D. & A.

<u>FORMATION</u>	<u>FROM</u>	<u>TO</u>	<u>REMARKS</u>
Surface Soil	0	160	Ran 288.42' of new 8-5/8" surface casing; set and cemented at 288.42' with 160 sacks of regular cement, 2% gel and 3% C. C. Plug down at 8:00 P. M. September 24, 1969.
Sand, Shale & Red Bed	160	308	
Red Bed & Shale	308	718	
Shale & Shells	718	1415	
Shells, Red Bed and Shale	1415	1514	
2nd Anhydrite	1514	1530	
Red Bed & Shale	1530	1815	
Shale & Lime	1815	4122	
Lime	4122	4360'	
Lime & Chert	4360	4398	

Total Depth 4398'

RECEIVED  
STATE CORPORATION COMMISSION  
OCT 9 1969  
CONSERVATION DIVISION  
Wichita, Kansas

D. & A.

Plugged hole as follows: Plugged at 650' with 70 sacks of cement; plugged at 270' with 30 sacks of cement; plugged at 40' with 10 sacks of cement. Plug down at 10:30 A. M. October 4, 1969.

STATE OF KANSAS )  
                          ) ss.  
COUNTY OF BARTON)

I certify that this is a true and correct copy of the above log to the best of my knowledge.

STRATA DRILLING, INC.

*Charles W. Steincamp*  
Charles W. Steincamp, President

Subscribed and sworn to before me this 6th day of October, 1969.

My Commission Expires:

*Elaine H. Taylor*  
Elaine H. Taylor, Notary Public

