

15.135-200,72-0000

STATE OF KANSAS  
STATE CORPORATION COMMISSION

Form CP-4

WELL PLUGGING RECORD

Give All Information Completely  
Make Required Affidavit  
Mail or Deliver Report to:  
Conservation Division  
State Corporation Commission  
212 No. Market  
Wichita, Kansas

Ness County, Sec. 14 Twp 20S Rge. (E)23 (W)

Location as "NE/CNW/SW" or footage from lines C NW SE

Lease Owner Pickrell Drilling Company

Lease Name Beardslee "A" Well No. 1

Office Address 705 Fourth National Bank Bldg., Wichita, Kansas 67202

Character of Well (completed as Oil, Gas or Dry Hole) Dry Hole

Date well completed October 22, 1967

Application for plugging filed October 22, 1967

Application for plugging approved October 22, 1967

Plugging commenced October 22, 1967

Plugging completed October 22, 1967

Reason for abandonment of well or producing formation Dry Hole


If a producing well is abandoned, date of last production 19

Was permission obtained from the Conservation Division or its agents before plugging was commenced? Yes

Name of Conservation Agent who supervised plugging of this well Leo Massey

Producing formation Depth to top Bottom Total Depth of Well 4450 Feet

Show depth and thickness of all water, oil and gas formations.

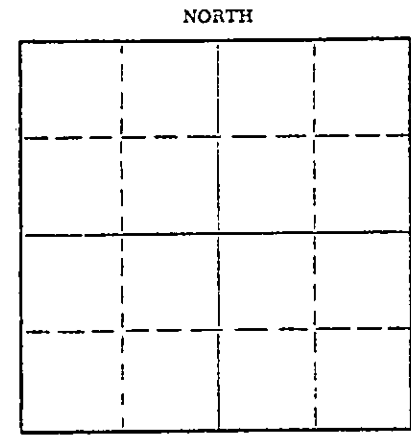

Locate well correctly on above Section Plot

OIL, GAS OR WATER RECORDS

CASING RECORD

FORMATION	CONTENT	FROM	TO	SIZE	PUT IN	PULLED OUT
				8 5/8"	268.55'	None

Describe in detail the manner in which the well was plugged, indicating where the mud fluid was placed and the method or methods used in introducing it into the hole. If cement or other plugs were used, state the character of same and depth placed, from feet to feet for each plug set.

Heavy mud to 660'. Set plug. Cemented with 100 sacks

Pozmix. Heavy mud to 260'. Set plug. Cemented with

25 sacks cement. Heavy mud to 40'. Set plug. Cemented

with 10 sacks cement to bottom of cellar. Plugged rat

hole with 2 sacks cement.

NOV 2 1967

Name of Plugging Contractor Pickrell Drilling Company  
Address 705 Fourth National Bank Bldg., Wichita, Kansas 67202

STATE OF KANSAS, COUNTY OF SEDGWICK, ss.

C. W. Sebitts (owner or operator) of the above-described


well, being first duly sworn on oath, says: That I have knowledge of the facts, statements and matters herein contained and the log of the above-described well as filed and that the same are true and correct. So help me God.

(Signature) C. W. Sebitts  
705 Fourth National Bank Bldg., Wichita, Kansas  
(Address)

Subscribed and sworn to before me this 31st day of October, 1967

My commission expires May 10, 1970

L. M. Whiting Notary Public.

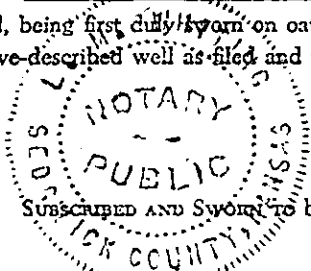

15-135-20072-0000

**ROTARY DRILLING LOG**

COMPANY: Pickrell Drilling Company  
705 Fourth National Bank Bldg.  
Wichita, Kansas 67202

Rotary Drilling Commenced 10/12/67

Rotary Drilling Completed 10/22/67

LOCATION: Beardslee "A" No. 1  
C NW SE Section 14-20S-23W  
Ness County, Kansas

CONTRACTOR: **PICKRELL DRILLING COMPANY**  
Wichita, Kansas

CASING RECORD: (14 jts.) 8 5/8" surface casing set at 268' and cemented with 160 sacks of cement. Circ. Completed 4:30 P.M., October 12, 1967. No oil string was run. D. & A., plugged October 22, 1967.

**LOG**

(Figures indicate bottom of formation — measurements from top of rotary bushing.)

75	Clay & Post Rock	C. F. S.
210	Shale & Shells	<u>4309'</u>
235	Sand	4335'
813	Shale & Shells	4355'
824	Blaine	4370'
930	Shale & Shells	4380'
1140	Sand	4390'
1479	Shale & Shells	4398'
1510	Anhydrite	4408'
2230	Shale & Shells	4414'
2420	Shale & Lime	4420'
2505	Lime	4432'
2660	Lime & Shale	4450'
2760	Lime	
3745	Lime & Shale	
4055	Lime	<u>Slope Tests</u>
4130	Lime & Shale	3500'
4198	Lime	4000'
4309	Lime & Shale	
4320	Sand	
4398	Lime & Shale	
4450	Mississippian, RTD	
		<u>S. L. M.</u>
	Board	3998.64'
	Strap	3985.87'
	Short	<u>2.77'</u>

STAMPED  
NOV 2 1967  
COMMISSION DIVISION  
WICHITA, KANSAS

The undersigned, C. W. Sebitts, Attorney-in-Fact for PICKRELL DRILLING COMPANY, hereby certifies in behalf of said Company, that the above is a true and correct log of the formation encountered in drilling the above well as reflected by the Daily Drilling Reports.

PICKRELL DRILLING COMPANY  
By C. W. Sebitts, Attorney-in-Fact

STATE OF KANSAS }  
COUNTY OF SEDGWICK } ss.:

On this 31st day of October, 19 67, before me the undersigned, a Notary Public, in and for the County and State aforesaid, personally appeared C. W. Sebitts, to me known to be the identical person who subscribed the name of PICKRELL DRILLING COMPANY to the foregoing instrument as its Attorney-in-Fact and acknowledged to me that he executed the same as his free and voluntary act and deed, and as the free and voluntary act and deed of such company, for the uses and purposes therein set forth.

Given under my hand and seal of office the day and year last above written.

My commission expires: May 10, 1970

L. M. Whiting  
Notary Public  
L. M. Whiting