

STATE OF KANSAS
STATE CORPORATION COMMISSION


WELL PLUGGING RECORD

Give All Information Completely
Make Required Affidavit
Mail or Deliver Report to
Conservation Division
State Corporation Comm.
245 North Water
Wichita, KS 67202

Greeley County. Sec. 9 Twp. 20 Rge. 40 N/W
Location as "NE/CNW $\frac{1}{4}$ SW $\frac{1}{4}$ " or footage from lines _____

C-NW NW
Lease Owner Bartling Oil Co.
Lease Name Peter Well No. 1

Office Address 8550 Katy Freeway Suite 128 Houston, Tex.
Character of Well (Completed as Oil, Gas or Dry Hole) 77024

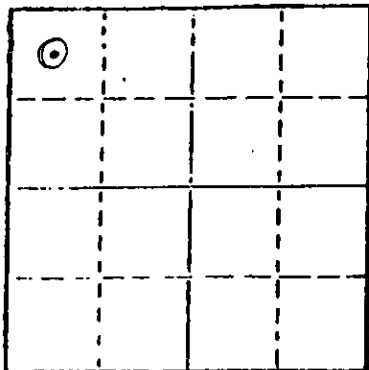

Locate well correctly on above
Section Plot

Date Well completed 9-26 1981
Application for plugging filed 9-26 1981
Application for plugging approved 9-26 1981
Plugging commenced 8:00 P.M. 9-26 1981
Plugging completed 12:00 Midnight 9-26 1981
Reason for abandonment of well or producing formation
Dry Hole

If a producing well is abandoned, date of last production
19

Was permission obtained from the Conservation Division or
its agents before plugging was commenced? Yes

Name of Conservation Agent who supervised plugging of this well Tommy Thomas
Producing formation _____ Depth to top _____ Bottom _____ Total Depth of Well 2925
Show depth and thickness of all water, oil and gas formations.

OIL, GAS OR WATER RECORDS

CASING RECORD

FORMATION	CONTENT	FROM	TO	SIZE	PUT IN	PULLED OUT
				8 5/8	291'	Left

Describe in detail the manner in which the well was plugged, indicating where the mud fluid
was placed and the method or methods used in introducing it into the hold. If cement or other
plugs were used, state the character of same and depth placed, from _____ feet to
_____ feet for each plug set.

Spot 50 Sx. @ 1180'
R. Plug 280' Then 40 Sx. @ 280'
10 Sx. 40' to 0
5 Sx. Rathole

(If additional description is necessary, use BACK of this sheet)

Name of Plugging Contractor Lakin Drilling Co.


STATE OF Kansas COUNTY OF Seward, ss.
Robert L. Higginbottom, Agent (employee of owner) or (owner or operator)
of the above-described well, being first duly sworn on oath, says: That I have knowledge of
the facts, statements, and matters herein contained and the log of the above-described well
as filed and that the same are true and correct. So help me God.

(Signature) [Signature]
P.O. Box 6, Liberal, Kansas 67901
(Address)

SUBSCRIBED AND SWORN TO before me this 21 st. day of October, 1981

[Signature]
Notary Public.

My commission expires

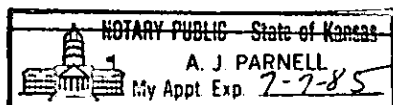

RECEIVED
STATE CORPORATION COMMISSION

10-22-81
CONSERVATION DIVISION
Wichita, Kansas

CONTRACTOR'S WELL LOG

OPERATOR: Bartling Oil Co.
 CONTRACTOR: Lakin Drilling Company
 WELL NAME: Peter # 1
 LOCATION: C-NW-NW 9-20-40
Greeley County, Kansas
 GEOLOGIST: _____
 SPUD DATE: 9-22-81
 COMPLETION DATE: 9-26-81

FOOTAGE:		
<u>0</u>	<u>200</u>	<u>Clay & Sand</u>
<u>200</u>	<u>291</u>	<u>Blue Shale</u>
<u>291</u>	<u>1615</u>	<u>Shale</u>
<u>1615</u>	<u>1898</u>	<u>Shale & Gyp</u>
<u>1898</u>	<u>2150</u>	<u>Salt</u>
<u>2150</u>	<u>2451</u>	<u>Shale & Shells</u>
<u>2450</u>	<u>2470</u>	<u>Anhy.</u>
<u>2470</u>	<u>2925</u>	<u>Anhy. & Lime & Sh.</u>
_____	<u>2925</u>	<u>T.D.</u>
_____	_____	_____
_____	_____	_____
_____	_____	_____
_____	_____	_____
_____	_____	_____
_____	_____	_____
_____	_____	_____

REPORT: Spud 12 1/4" Hole @ 8:00 A.M. 9-22-81. 12 1/4" Hole to 291'
Ran 7 Jts. 8 5/8" 281' Set @ 291' Cement with 225 "H" 3/4 c.c.
Plug down @ 2:45 P. M. 9-22-81 by Dowell.
Plug hole with 50 sx. @ 1180'
R. Plug to 280' then 40 Sx. @ 280'
10 Sx. @ 40' to 0
5 Sx. Rathole
Completed @ 12:00 Midnight 9-26-81 by Howee

State of Kansas County of Kearny
 Louis C Blankenship, Drilling Supt for Lakin Drilling Co, does hereby state that
 the above and foregoing is a true and correct copy of the log of the Peter # 1
lease; 9-20-40 (legal); Greeley (county); Kansas.

LAKIN DRILLING COMPANY
 By: [Signature]
Louis C Blankenship, Drilling Supt.

Subscribed and sworn to before me, a Notary Public, in and for the aforesaid county
 and state as of this 30th day of Sept., 19 81.


 NINA M. WELLMAKER
 NOTARY PUBLIC
 State of Kansas
 My Appointment Expires
6-15-85
 My Commission Expires: 6-15-85

[Signature]
 Notary Public
 STATE CORPORATION COMMISSION

CONSERVATION DIVISION
 Wichita, Kansas