


STATE OF KANSAS  
STATE CORPORATION COMMISSION

WELL PLUGGING RECORD

Give All Information Completely  
Make Required Affidavit  
Mail or Deliver Report to  
Conservation Division  
State Corporation Comm.  
245 North Water  
Wichita, KS 67202

Greely County. Sec. 13 Twp. 17 Rge. 41 ~~EX~~  
 Location as "NE/CNW $\frac{1}{4}$ SW $\frac{1}{4}$ " or footage from lines  
 C-NW-NE  
 Lease Owner Energy Service Corporation  
 Lease Name Bounds Well No. \_\_\_\_\_  
 Office Address 210 Petroleum Bldg., Wichita, Ks. 67202  
 Character of Well (Completed as Oil, Gas or Dry Hole)  
 Gas  
 Date Well completed 12-20-80 19  
 Application for plugging filed 6-15-80 19  
 Application for plugging approved 6-20-80 19  
 Plugging commenced 8-21-80 19  
 Plugging completed 8-25-80 19  
 Reason for abandonment of well or producing formation  
 Non Commercial Value  
 If a producing well is abandoned, date of last production  
 None 19  
 Was permission obtained from the Conservation Division or  
 its agents before plugging was commenced? yes  
 Name of Conservation Agent who supervised plugging of this well Mr. Baltazar  
 Producing formation Hugoton Depth to top 2931 Bottom 2946 Total Depth of Well 3038  
 Show depth and thickness of all water, oil and gas formations.

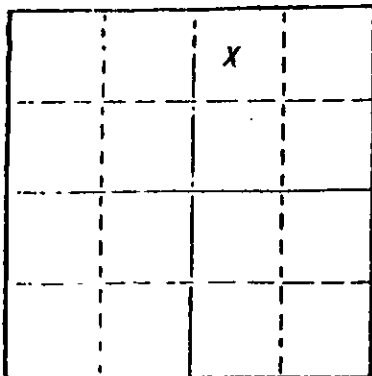

Locate well correctly on above  
Section Flat

OIL, GAS OR WATER RECORDS

CASING RECORD

FORMATION	CONTENT	FROM	TO	SIZE	PUT IN	PULLED OUT
Surface				8 5/8"	300'	0'
Production				4 1/2"	3031'	2450'

Describe in detail the manner in which the well was plugged, indicating where the mud fluid was placed and the method or methods used in introducing it into the hold. If cement or other plugs were used, state the character of same and depth placed, from \_\_\_\_\_ feet to \_\_\_\_\_ feet for each plug set.

- Pumped sk. hulls & 10 sks. cement to 2800' Pressured to 750 lbs.
- Pumped 35 sks. cement 1100' to 880'
- Pumped 30 sks. cement 300' to 200'
- Put bridge & 10 sks. cement 40' to 0'
- Cut off 85/8" 3' below ground level

RECEIVED  
 STATE CORPORATION COMMISSION  
 SEP 16 1980  
 CONSERVATION DIVISION  
 Wichita, Kansas

(If additional description is necessary, use BACK of this sheet)

Name of Plugging Contractor Midwest Casing Pulling Service, Box F, Sublette, Ks. 67877

STATE OF Kansas COUNTY OF Haskell, ss.  
 I, Edgar J. Eves (employee of owner) or (owner or operator)  
 of the above-described well, being first duly sworn on oath, says: That I have knowledge of the facts, statements, and matters herein contained and the log of the above-described well as filed and that the same are true and correct. So help me God.

(Signature) Edgar J. Eves  
 Box F, Sublette, Ks. 67877  
 (Address)

SUBSCRIBED AND SWORN TO before me this 15th day of Sept., 1980

Sandra L. Eves  
 Notary Public.

My commission expires 12-6-80

