

STATE OF KANSAS  
STATE CORPORATION COMMISSION


Form CP-4

Give All Information Completely  
Make Required Affidavit  
Mail or Deliver Report to:  
Conservation Division  
State Corporation Commission

WELL PLUGGING RECORD

P. O. Box 17027  
Wichita, Kansas 67217  
NORTH

Greeley County, Sec. 21 Twp. 17 Rge. 41 XEY X (W)  
Location as "NE/CNW/SW" or footage from lines C SE NW  
Lease Owner Banks & Rhodes  
Lease Name Wheeler Well No. 1  
Office Address Box 242; Midland, Texas 79701  
Character of Well (completed as Oil, Gas or Dry Hole) Dry Hole  
Date well completed April 12 19 75  
Application for plugging filed June 15 19 75  
Application for plugging approved June 18 19 75  
Plugging commenced June 18 19 75  
Plugging completed June 19 19 75  
Reason for abandonment of well or producing formation Non-commercial

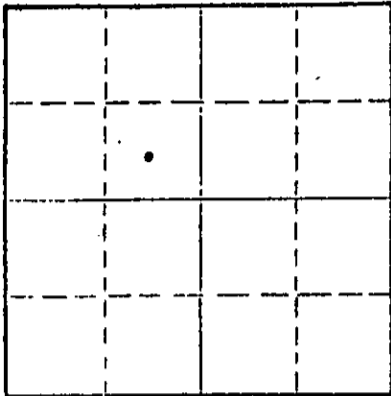

Locate well correctly on above  
Section Plot

If a producing well is abandoned, date of last production - 19  
Was permission obtained from the Conservation Division or its agents before plugging was commenced? Yes

Name of Conservation Agent who supervised plugging of this well Gilbert Balthazor  
Producing formation \_\_\_\_\_ Depth to top \_\_\_\_\_ Bottom \_\_\_\_\_ Total Depth of Well 3006 Feet  
Show depth and thickness of all water, oil and gas formations.

OIL, GAS OR WATER RECORDS

CASING RECORD

FORMATION	CONTENT	FROM	TO	SIZE	PUT IN	PULLED OUT
				13-3/8"	515	None
				8-5/8"	2686'	None
				4-1/2"	3317'	2180

Describe in detail the manner in which the well was plugged, indicating where the mud fluid was placed and the method or methods used in introducing it into the hole. If cement or other plugs were used, state the character of same and depth placed, from \_\_\_\_\_ feet to \_\_\_\_\_ feet for each plug set.

Pumped 2 sks of hulls & 10 sks of cement to 2400  
Pumped 70 sks of cement from 550 to 340  
Put Bridge & 15 sks of cement from 45 to 0

RECEIVED  
STATE CORPORATION COMMISSION

JUL 16 1975  
7-16-75  
CONSERVATION DIVISION  
Wichita, Kansas

(If additional description is necessary, use BACK of this sheet)  
Name of Plugging Contractor Sargents Casing Pulling Service Kansas No. 511  
Address Box 506 Liberal, Kansas 67901

STATE OF KANSAS, COUNTY OF SEWARD ss.  
R. L. Higginbottom (employee of owner) of the above-described well, being first duly sworn on oath, says: That I have knowledge of the facts, statements, and matters herein contained and the log of the above-described well as filed and that the same are true and correct. So help me God.

(Signature) *R. L. Higginbottom*  
P. O. Box 6 Liberal, Kans. 67901 (Address)

SUBSCRIBED AND SWORN TO before me this 14th day of July, 19 75

My commission expires \_\_\_\_\_  
A. J. PARNELL  
STATE NOTARY PUBLIC  
Seward County, Kansas  
My Commission Expires  
June 6, 1977

*A. J. Parnell*  
Notary Public.