


STATE OF KANSAS
STATE CORPORATION COMMISSION

Form CP-4

Give All Information Completely
Make Required Affidavit
Mail or Deliver Report to:
Conservation Division
State Corporation Commission

P. O. Box 17027
Wichita, Kansas 67217
NORTH

WELL PLUGGING RECORD

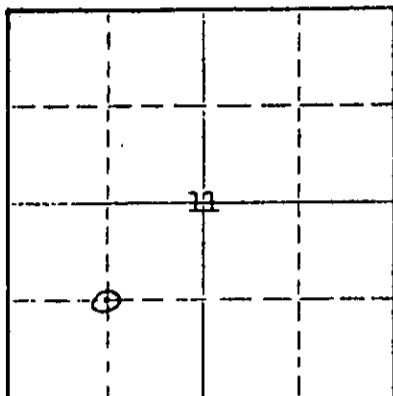

Locate well correctly on above
Section Plat

Greeley County, Sec. 11 Twp. 20S Rge. 40 (E) X (W)
Location as "NE/CNW/SW" or footage from lines C SW/4
Lease Owner Dorchester Exploration Incorporated
Lease Name Grimes Well No. 1
Office Address 1204 Vaughn Bldg; Midland, Texas 79701
Character of Well (completed as Oil, Gas or Dry Hole) Gas-Dry Hole
Date well completed August 15 19 72
Application for plugging filed October 19 73
Application for plugging approved _____ 19 _____
Plugging commenced January 24 19 74
Plugging completed January 25 19 74
Reason for abandonment of well or producing formation non-commercial

If a producing well is abandoned, date of last production none 19 _____
Was permission obtained from the Conservation Division or its agents before plugging was commenced? Yes

Name of Conservation Agent who supervised plugging of this well W. L. Nichols
Producing formation Winfield Depth to top 2825 Bottom 2848 Total Depth of Well 2853 Feet
Show depth and thickness of all water, oil and gas formations.

OIL, GAS OR WATER RECORDS

CASING RECORD

FORMATION	CONTENT	FROM	TO	SIZE	PUT IN	PULLED OUT
Winfield	Water	2825	2848	8-5/8	420'	none
				4-1/2"	2857'	2301

Describe in detail the manner in which the well was plugged, indicating where the mud fluid was placed and the method or methods used in introducing it into the hole. If cement or other plugs were used, state the character of same and depth placed, from _____ feet to _____ feet for each plug set.

Squeeze bottom of 4-1/2" casing with 20 sacks cement with plug @ 2600' - shoot off 4-1/2" @ 2301' - pull 4 1/2" to 475'. Displace 40 sx thru 4 1/2" @ 475' - pull remaining 4 1/2" casing. Bridge 8-5/8" casing @ 40' - 10 sx cement from 40' to bottom cellar @ 3' - cut off 8-5/8" csg. @ 3' below ground level, weld plate on top of 8-5/8" casing.

RECEIVED
STATE CORPORATION COMMISSION
MAR 11 1974
3-11-74
CONSERVATION DIVISION
Wichita, Kansas

(If additional description is necessary, use BACK of this sheet)

Name of Plugging Contractor Sargent Casing Pullers
Address Liberal, Kansas 67901

STATE OF KANSAS, COUNTY OF SEWARD, ss.
R. L. Higginbottom (employee of owner) or (owner or operator) of the above-described well, being first duly sworn on oath, says: That I have knowledge of the facts, statements, and matters herein contained and the log of the above-described well as filed and that the same are true and correct. So help me God.

(Signature) [Signature]
Box 6; Liberal, Kansas 67901
(Address)

SUBSCRIBED AND SWORN to before me this 6th day of March 19 74

My commission expires _____
A. J. PARNELL
PUBLIC
JUN 6, 1977

[Signature]
A. J. Parnell Notary Public.

RECEIVED
STATE CORPORATION COMMISSION

AUG 23 1974

CONSERVATION DIVISION
Wichita, Kansas

STERLING DRILLING COMPANY
P. O. Box 129
Sterling, Kansas 67579

15-071-20011-0000

WELL LOG ----- GRIMES #1-11
Located: C SW, Section 11-20S-40W, Wallace County, Kansas

OWNER: Singer-Fleischaker Oil Company
ROTARY DRILLING CONTRACTOR: Sterling Drilling Company

COMMENCED: March 14, 1972
COMPLETED: March 19, 1972

TOTAL DEPTH: 2857'

<u>LOG</u>		<u>CASING RECORD</u>
0 - 186	Clay and Shale Sand	Ran 10 joints 8 5/8" 23# new casing. 403' set at 419.5 K.B. Cemented with 150 sacks light weight with 2% cc - 150 sacks common with 3% cc. Plug down 7:45 AM, 3-15-72.
186 - 635	Sand and Shale	
635 - 1375	Shale	
1375 - 1648	Shale and Lime	
1648 - 1756	Shale - Shells	
1756 - 1780	Blaine Anhydrite	
1780 - 2130	Shale	
2130 - 2846	Lime and Shale	
2846 - 2857	Lime	

Sorry this was not done sooner but no records were available on this well. It was necessary to go to Sterling Drilling to obtain this copy
RMD