

15-071-20042-0000


STATE OF KANSAS
CONSERVATION COMMISSION

Give All Information Completely
Make Required Affidavit
Mail or Deliver Report to:
Conservation Division
State Corporation Commission
P. O. Box 17027
Wichita, Kansas 67217
NORTH

WELL PLUGGING RECORD

Greely County, Sec. 26 Twp. 20 Rgs. 10 (E) (W) X
C SE NW

Location as "NE/CNW/SE/SW" or footage from lines _____
Lease Owner Hughes Seewald
Lease Name Copeland Well No. 1
Office Address 701 1st. Natl. Bk. Bldg. Amarillo, Texas 79101
Character of Well (completed as Oil, Gas or Dry Hole) Gas Dry
Date well completed _____ 19____
Application for plugging filed _____ 19____
Application for plugging approved April 16, 1975 19____
Plugging commenced _____ 5-1 1975
Plugging completed _____ 5-6 1975
Reason for abandonment of well or producing formation dry hole

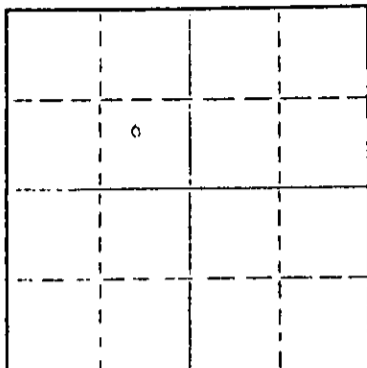

Locate well correctly on above Section Plat

If a producing well is abandoned, date of last production none 19____
Was permission obtained from the Conservation Division or its agents before plugging was commenced? Yes

Name of Conservation Agent who supervised plugging of this well Balthazor
Producing formation _____ Depth to top _____ Bottom _____ Total Depth of Well 2850 feet
Show depth and thickness of all water, oil and gas formations

OIL, GAS OR WATER RECORDS

CASING RECORD

FORMATION	CONTENT	FROM	TO	SIZE	PUT IN	PULLED OUT
				8 5/8	325	none
				1 1/2	2848	1418

Describe in detail the manner in which the well was plugged, indicating where the mud fluid was placed and the method or methods used in introducing it into the hole. If cement or other plugs were used, state the character of same and depth placed, from _____ feet to _____ feet for each plug set.

Pump 35 sks. of cement from 800 to 700
Pump 35 sks. of cement from 325 to 225
Put bridge & 10 sks. of cement from 45 to 0

JUN 6-9-75

(If additional description is necessary, use BACK of this sheet)
Name of Plugging Contractor Sargents Casing Pulling Service Kansas No. 511
Address Box 506 Liberal, Kansas 67901

STATE OF Texas COUNTY OF Potter, ss.

_____, (employee of owner) or (owner or operator) of the above-described well, being first duly sworn on oath, says: That I have knowledge of the facts, statements, and matters herein contained and the log of the above-described well as filed and that the same are true and correct. So help me God.

(Signature) Hughes Seewald
701 1st Natl Bank Bldg Amarillo Tex
(Address) 79101

Subscribed and Sworn to before me this 5th day of June, 1975

My commission expires 6-1-77 _____
Notary Public.

KANSAS DRILLERS LOG

IMPORTANT
Kans. Geo. Survey request
samples on this well.

T. 26 R. 40 E
W
Loc. 1980 FNL 1980 FWL

API No. 15 — 071 — 20,042-0000
County Number

Operator
Hughes Seewald
Address 701 First National Bank Building
Amarillo, Texas

Well No. #1 Lease Name Coupland


Footage Location
1980 feet from (N) line 1980 feet from (W) line

Principal Contractor Sterling Drilling Co. Geologist Ralph Reynolds

Spud Date June 16, 1973 Total Depth 2850 P.B.T.D.

Date Completed _____ Oil Purchaser _____

County Greeley

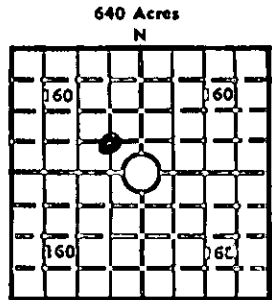

Elev.: Gr. 3560

DF _____ KB 3570

CASING RECORD

Report of all strings set — surface, intermediate, production, etc.

Purpose of string	Size hole drilled	Size casing set (in O.D.)	Weight lbs/ft.	Setting depth	Type cement	Sacks	Type and percent additives
Surface	12 1/2"	8-5/8"	24#	324'	Quickset	225	3% CC
Production	7-7/8"	4 1/2"	10.5#	2850	Pozmix	200	

LINER RECORD

PERFORATION RECORD

Top, ft.	Bottom, ft.	Sacks cement	Shots per ft.	Size & type	Depth interval
none			none		

Size	Setting depth	Pecker set at
none		

ACID, FRACTURE, SHOT, CEMENT SQUEEZE RECORD

Amount and kind of material used	STATE CORPORATION COMMISSION	Depth interval treated
none	APR 16 1975	
	CONSERVATION DIVISION Wichita, Kansas	

INITIAL PRODUCTION

Date of first production none	Producing method (flowing, pumping, gas lift, etc.)				
RATE OF PRODUCTION PER 24 HOURS	Oil bbls.	Gas MCF	Water bbls.	Gas-oil ratio CFPB	
Disposition of gas (vented, used on lease or sold)			Producing interval (s)		

INSTRUCTIONS: As provided in KCC Rule 82-2-125, within 90 days after completion of a well, one completed copy of this Drillers Log shall be transmitted to the State Geological Survey of Kansas, 4150 Monroe Street, Wichita, Kansas 67209. Copies of this form are available from the Conservation Division, State Corporation Commission, 3830 So. Meridian (P.O. Box 17027), Wichita, Kansas 66217. Phone AC 316-522-2206. If confidential custody is desired, please note Rule 82-2-125. Drillers Logs will be on an open file in the Oil and Gas Division, State Geological Survey of Kansas, Lawrence, Kansas 66044.

Operator Hughes Seewald		DESIGNATE TYPE OF COMP.: OIL, GAS, DRY HOLE, SWDW, ETC.:
Well No. 1	Lease Name Coupland	Dry Hole
S 26 T 20S R 40 W		


WELL LOG

Show all important zones of porosity and contents thereof; cored intervals, and all drill-stem tests, including depth interval tested, cushion used, time tool open, flowing and shut-in pressures, and recoveries.

SHOW GEOLOGICAL MARKERS, LOGS RUN, OR OTHER DESCRIPTIVE INFORMATION.

FORMATION DESCRIPTION, CONTENTS, ETC.	TOP	BOTTOM	NAME	DEPTH
None			Acoustic Velocity	

USE ADDITIONAL SHEETS, IF NECESSARY, TO COMPLETE WELL RECORD.

Date Received	 Signature
	Operator
	Title
	April 9, 1975 Date