


WELL PLUGGING RECORD

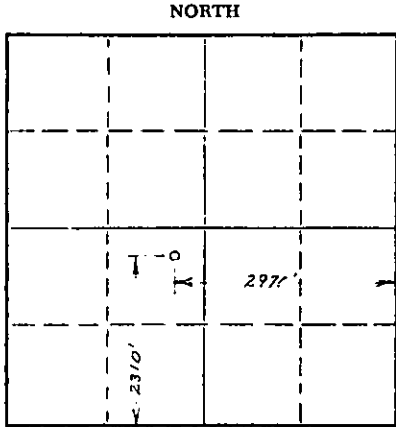

Greeley County, Sec. 24 Twp. 20 Rge. 40 (W)  
Location as "NE/CNW/SW" or footage from lines NE/NE/SW  
Lease Owner Kansas-Nebraska Natural Gas Company, Inc.  
Lease Name Watson Well No. 1  
Office Address 300 N. St. Joseph Ave., Hastings, Nebraska  
Character of Well (completed as Oil, Gas or Dry Hole) Dry Hole  
Date well completed 12-29 1960  
Application for plugging filed Yes April 21 1961  
Application for plugging approved 19  
Plugging commenced April 17 1961  
Plugging completed 1 P.M. April 17 1961  
Reason for abandonment of well or producing formation Dry Hole  
If a producing well is abandoned, date of last production 19  
Was permission obtained from the Conservation Division or its agents before plugging was commenced? Yes

Name of Conservation Agent who supervised plugging of this well Mr. Gilbert Leiker, Victoria, Kansas  
Producing formation Depth to top Bottom Total Depth of Well 2894 Feet  
Show depth and thickness of all water, oil and gas formations.

OIL, GAS OR WATER RECORDS					CASING RECORD	
FORMATION	CONTENT	FROM	TO	SIZE	PUT IN	PULLED OUT
				8-5/8"	291	None
				5-1/2"	2887	2248

Describe in detail the manner in which the well was plugged, indicating where the mud fluid was placed and the method or methods used in introducing it into the hole. If cement or other plugs were used, state the character of same and depth placed, from feet to feet for each plug set.  
Plugged back with gravel 2856 to 2816. Dumped 4 sks. cement with bailer, January 27, 1961, cement plug 2816 to 2786.  
Shot pipe off and recovered 2248 ft. 5 1/2" casing. Filled hole with rotary mud to 280 ft. Bridged hole and dumped 20 sacks cement. Cement plug from 280 ft. to 225 ft. Filled with mud, 225 ft. to 34 feet. Top cement plug 10 sacks 34 ft. to 5 ft.

(If additional description is necessary, use BACK of this sheet)  
Name of Plugging Contractor Southwest Casing Pulling Company  
Address Great Bend, Kansas

STATE OF COUNTY OF ss.  
(employee of owner) or (owner or operator) of the above-described well, being first duly sworn on oath, says: That I have knowledge of the facts, statements, and matters herein contained and the log of the above-described well as filed and that the same are true and correct. So help me God.

(Signature) S. D. FORD, JR.  
Hastings, Nebraska  
(Address)

SUBSCRIBED AND SWORN TO before me this 24th day of April, 1961  
October 23, 1965  
My commission expires  
J. ROLAND MILLER  
Notary Public.