

STATE CORPORATION COMMISSION OF KANSAS
OIL & GAS CONSERVATION DIVISION
WELL COMPLETION OR RECOMPLETION FORM
ACO-1 WELL HISTORY
DESCRIPTION OF WELL AND LEASE

API NO. 15-057-20,448
County Ford
NW SW NE 35 25 21 East
V..... Sec..... Twp..... Rge..... X West

Operator: License # 5015
Name Hallar Drilling Company, Inc.
Address 711 Petroleum Bldg
City/State/Zip Wichita, KS 67202

3630 Ft North from Southeast Corner of Section
2310 Ft West from Southeast Corner of Section
(Note: Locate well in section plat below)

Purchaser Clear Creek
McPherson, Ks.

Lease Name KATE Well # 2
Field Name Coon Creek North

Operator Contact Person D. L. Hellar
Phone 316/267-2845

Producing Formation Miss
Elevation: Ground 2293 2303 KB

Contractor: License # 5104
Name Blue Goose Drilling, Inc.

Wellsite Geologist Boh Douglass
Phone 316/263-7135

RECEIVED
STATE CORPORATION COMMISSION


Designate Type of Completion
X New Well Re-Entry Workover

JUN - 9 1988

X Oil SWD Temp Abd
Gas Inj Delayed Comp.
Dry Other (Core, Water Supply etc.)

CONSERVATION DIVISION
Wichita, Kansas

If OWNQ: old well info as follows:

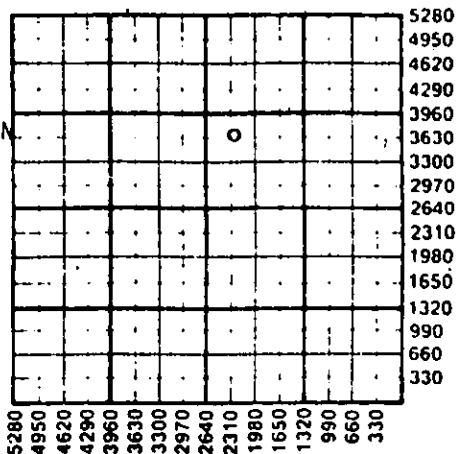

Operator
Well Name
Comp. Date Old Total Depth

WATER SUPPLY INFORMATION

Disposition of Produced Water: Disposal
Docket # Repressuring

WELL HISTORY

Drilling Method:
X Mud Rotary Air Rotary Cable

3/21/88 3/31/88 4/28/88
Spud Date Date Reached TD Completion Date

4634 4813
Total Depth PBTD

Amount of Surface Pipe Set and Cemented at 417 feet
Multiple Stage Cementing Collar Used? Yes X No
If yes, show depth set feet
If alternate 2 completion, cement circulated from feet depth to w/SX cmt
Cement Company Name
Invoice #

Questions on this portion of the ACO-1 call:
Water Resources Board (913) 296-3717
Source of Water:
Division of Water Resources Permit #
Groundwater Ft North from Southeast Corner (Well) Ft West from Southeast Corner of Sec Twp Rge East West
Surface Water Ft North from Southeast Corner (Stream, pond etc) Ft West from Southeast Corner Sec Twp Rge East West
Other (explain) landowners water well (purchased from city, R.W.D. #)

INSTRUCTIONS: This form shall be completed in triplicate and filed with the Kansas Corporation Commission, 200 Colorado Derby Building, Wichita, Kansas 67202, within 120 days of the spud date of any well. Rule 82-3-130, 82-3-107 and 82-3-106 apply. Information on side two of this form will be held confidential for a period of 12 months if requested in writing and submitted with the form. See rule 82-3-107 for confidentiality in excess of 12 months. One copy of all wireline logs and drillers time log shall be attached with this form. Submit CP-4 form with all plugged wells. Submit CP-111 form with all temporarily abandoned wells.

All requirements of the statutes, rules and regulations promulgated to regulate the oil and gas industry have been fully complied with and the statements herein are complete and correct to the best of my knowledge.

Signature D. L. Hellar
Title President Date 6/6/88

Subscribed and sworn to before me this 6 day of JUNE 1988
Notary Public Catherine Darcey
Notary Public - Catherine Darcey
Date Commission Expires March 25, 1992

K.C.C. OFFICE USE ONLY
F Letter of Confidentiality Attached
C Wireline Log Received
C Drillers Time Log Received
Distribution
KCC SWD/Rep NGPA
KGS Plug Other (Specify)
6-9-88

Sec 35 Twp. 25 Rge. 21 W

