

TYPE

AFFIDAVIT OF COMPLETION FORM

ACO-1 WELL HISTORY

SIDE ONE

Two (2) copies of this form shall be filed with the Kansas Corporation Commission, 200 Colorado Derby Building, Wichita, Kansas 67202, within thirty (30) days after the completion of a well, regardless of how the well was completed.

Attach separate letter of request if the information is to be held confidential. If confidential, only file one copy. Information on Side One will be of public record and Side Two will then be held confidential.

Applications must be made on dual completion, commingling, salt water disposal, injection and temporarily abandoned wells.

Attach one copy only wireline logs (i.e. electrical log, sonic log, gamma ray neutron log, etc.). (Rules 82-2-105 & 82-2-125) KCC# (316) 263-3238.

LICENSE # 5171 EXPIRATION DATE November 5, 1983

OPERATOR TXO Production Corp. API NO. 15-071-20304-0000

ADDRESS 1800 Lincoln Center Bldg. COUNTY Greeley

Denver, Colorado 80264 FIELD Stockholm

** CONTACT PERSON Frank Tsuru PROD. FORMATION Morrow

PHONE (303) 861-4246

PURCHASER The Permian Corp. LEASE Cheek A

ADDRESS 9810 E. 42nd Street, Suite 233 WELL NO. 1

Tulsa, Oklahoma 74145 WELL LOCATION NE NE SW


DRILLING J.W. Gibson Drilling Company 2310 Ft. from south Line and

CONTRACTOR CONTRACTOR ADDRESS 1204 Burlington Avenue 2970 Ft. from east Line of

Fort Morgan, Colorado 80701 the SW (Qtr.) SEC 11 TWP 16 SRGE 43W.

PLUGGING None WELL PLAT

CONTRACTOR CONTRACTOR ADDRESS

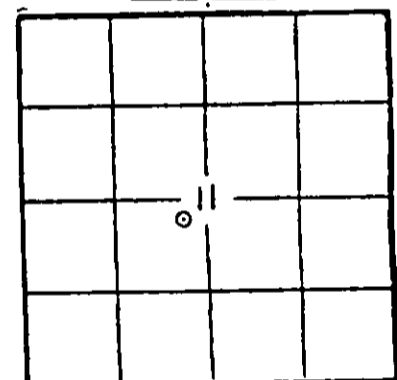

(Office Use Only) KCC [checked] KGS [checked] SWD/REP PLG.

TOTAL DEPTH 5300 PBD 5257

SPUD DATE 8/26/83 DATE COMPLETED 9/22/83

ELEV: GR 3910 DF KB 3920

DRILLED WITH ~~XXXXXXXX~~ (Rotary) (~~XXXX~~ TOOLS.

DOCKET NO. OF DISPOSAL OR REPRESSURING WELL BEING USED TO DISPOSE OF WATER FROM THIS LEASE N/A

Amount of surface pipe set and cemented 462' DV Tool Used? Yes

THIS AFFIDAVIT APPLIES TO: (Circle ONE) - (Oil) Gas, Shut-in Gas, Dry, Disposal, Injection, Temporarily Abandoned, OWWO. Other

ALL REQUIREMENTS OF THE STATUTES, RULES AND REGULATIONS PROMULGATED TO REGULATE THE OIL AND GAS INDUSTRY HAVE BEEN FULLY COMPLIED WITH.

A F F I D A V I T

Russ E. Gillis, being of lawful age, hereby certifies that:

I am the Affiant, and I am familiar with the contents of the foregoing Affidavit. The statements and allegations contained therein are true and correct.

Russ E. Gillis (Name)

SUBSCRIBED AND SWORN TO BEFORE ME this 28 day of September, 1983.

Nada J. Branson (NOTARY PUBLIC)

My Commission Expires Dec. 14, 1988 3220 Perry St., Westminster, CO 80030

RECEIVED STATE CORPORATION COMMISSION

** The person who can be reached by phone regarding any questions concerning this information.

OCT 3 1983 10-3-83 CONSERVATION DIVISION Wichita, Kansas

7670 44 7385 13206

SIDE TWO

OPERATOR TXO Production Corp. LEASE Cheek "A" #1 SEC. 11 TWP. 16S RCL. 4X

FILL IN WELL LOG AS REQUIRED:

FORMATION DESCRIPTION, CONTENTS, ETC.			TOP	BOTTOM	NAME	DEPTH
No DST's run. Lower Morrow Sd: bright yellow fluorescence & good stain			5152	5165	Marmaton	4605
					Atoka	4875
					Morrow	5035
					Lower Morrow	5143
					Mississippian	5245

RELEASED
 OCT 12 1984
 FROM CONFIDENTIAL

Report of all strings set—surface, intermediate, production, etc. CASING RECORD (New) or (Used)

Purpose of string	Size hole drilled	Size casing set (in O.D.)	Weight lbs/ft.	Setting depth	Type cement	Sacks	Type and percent additives
Surface	12-1/4	8-5/8	24	462	Cl "C"	275	3% CaCl ₂
Production	7-7/8	4-1/2	10.5	5292	50/50 poz	250	5% salt
							3/4% D-65

LINER RECORD			PERFORATION RECORD		
Top, ft.	Bottom, ft.	Sacks cement	Shots per ft.	Size & type	Depth interval
TUBING RECORD			2	0.38" jet	5152-5165
Size	Setting depth	Packer set at			
2-3/8	5216				

ACID, FRACTURE, SHOT, CEMENT SQUEEZE RECORD

Amount and kind of material used	Depth interval treated
Natural	

Date of first production 9/22/83	Producing method (flowing, pumping, gas lift, etc.) Pumping	Gravity 40° API
RATE OF PRODUCTION PER 24 HOURS	Oil 167 bbls.	Gas — MCF
	Water % 4 bbls.	Gas-oil ratio — CFPS
Disposition of gas (vented, used on lease or sold) Used on lease		Perforations 5152-5165