

ORIGINAL

SIDE ONE

9/19/90  
9-49-91

0000 8 1

STATE CORPORATION COMMISSION OF KANSAS  
OIL & GAS CONSERVATION DIVISION  
WELL COMPLETION FORM  
ACO-1 WELL HISTORY  
DESCRIPTION OF WELL AND LEASE

API NO. 15- 171-20,390-0000  
County SCOTT FROM CONFIDENTIAL  
C SW NW Sec. 4 Twp. 18S Rge. 31 XX East West

Operator: License # 3988  
Name: Slawson Exploration Company, Inc.  
Address 104 S. Broadway  
Wichita, Kansas 67202  
City/State/Zip \_\_\_\_\_

3300 Ft. North from Southeast Corner of Section  
4620 Ft. West from Southeast Corner of Section  
(NOTE: Locate well in section plat below.)

Purchaser: \_\_\_\_\_  
Operator Contact Person: James C. Remsberg  
Phone (316) 263-3201


Lease Name CARSON "T" Well # 1  
Field Name Wildcat

Contractor: Name: L. D. Drilling, Inc.  
License: 6039  
Wellsite Geologist: George Mueller

Producing Formation \_\_\_\_\_  
Elevation: Ground 2958 KB 2963  
Total Depth 4650 PBD \_\_\_\_\_

Designate Type of Completion  
 New Well  Re-Entry  Workover  
 Oil  SWD  Temp. Abd.  
 Gas  Inj  Delayed Comp.  
 Dry  Other (Core, Water Supply, etc.)

OCT 03 1989  
KANSAS CORPORATION COMMISSION  
SEPT 19 1989

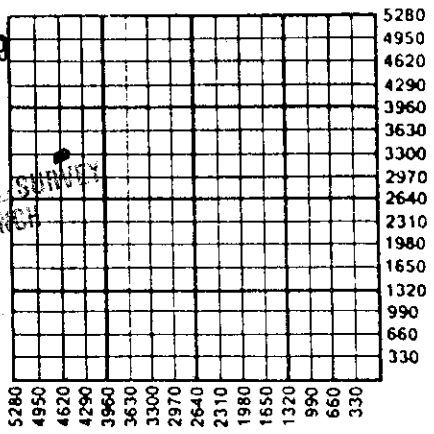

ACT II  
DFA

If **OWNED**: old well info as follows:  
Operator: \_\_\_\_\_  
Well Name: \_\_\_\_\_  
Comp. Date \_\_\_\_\_ Old Total Depth \_\_\_\_\_  
Drilling Method:  
 Mud Rotary  Air Rotary  Cable  
8-2-89 8-10-89 8-10-89  
Spud Date Date Reached TD Completion Date

Amount of Surface Pipe Set and Cemented at 365 Feet  
Multiple Stage Cementing Collar Used?  Yes  No  
If yes, show depth set \_\_\_\_\_ Feet  
If Alternate II completion, cement circulated from \_\_\_\_\_  
feet depth to \_\_\_\_\_ w/ \_\_\_\_\_ sx cmt.

**INSTRUCTIONS:** This form shall be completed in triplicate and filed with the Kansas Corporation Commission, 200 Colorado Derby Building, Wichita, Kansas 67202, within 120 days of the spud date of any well. Rule 82-3-130, 82-3-107 and 82-3-106 apply. Information on side two of this form will be held confidential for a period of 12 months if requested in writing and submitted with the form. See rule 82-3-107 for confidentiality in excess of 12 months. **One copy of all wireline logs and drillers time log shall be attached with this form. ALL CEMENTING TICKETS MUST BE ATTACHED.** Submit CP-4 form with all plugged wells. Submit CP-111 form with all temporarily abandoned wells. Any recompletion, workover or conversion of a well requires filing of ACO-2 within 120 days from commencement date of such work.

All requirements of the statutes, rules and regulations promulgated to regulate the oil and gas industry have been fully complied with and the statements herein are complete and correct to the best of my knowledge.  
SLAWSON EXPLORATION COMPANY, INC.

Signature James C. Remsberg  
Title James C. Remsberg, Operations Mgr Date 08/17/89  
Subscribed and sworn to before me this 17 day of August,  
19 89.  
Notary Public Elizabeth Cochran  
Date Commission Expires \_\_\_\_\_

ELIZABETH COCHRAN  
NOTARY PUBLIC  
STATE OF KANSAS  
My Appt. Exp. 7-8-90

**K.C.C. OFFICE USE ONLY**  
 Letter of Confidentiality Attached  
 Wireline Log Received  
 Drillers Timelog Received  
**Distribution**  
 KCC  SWD/Rep  NGPA  
 KGS  Plug  Other  
(Specify)

CONFIDENTIAL

SIDE TWO

Operator Name SLAWSON EXPLORATION COMPANY, INC. Lease Name CARSON "T" Well # 1
County SCOTT
Sec. 4 Twp. 18S Rge. 31 [X] West

INSTRUCTIONS: Show important tops and base of formations penetrated. Detail all cores. Report all drill stem tests giving interval tested, time tool open and closed, flowing and shut-in pressures, whether shut-in pressure reached static level, hydrostatic pressures, bottom hole temperature, fluid recovery, and flow rates if gas to surface during test. Attach extra sheet if more space is needed. Attach copy of log.

Drill Stem Tests Taken [X] Yes [ ] No
Samples Sent to Geological Survey [X] Yes [ ] No
Cores Taken [ ] Yes [X] No
Electric Log Run [ ] Yes [ ] No

Formation Description

[ ] Log [ ] Sample

Table with columns: Name, Top, Bottom. Includes FORMATION DATA: Sample with values for ANHY, Base Anhy, TOP, HEEB, LANS, MUN CR, STK, BKC, PLEAS, ALT B, PAW, RTD.

DST #1 4344-4388' ALTA Zn. Wk to no bl.
Rec 35' drlg mud. IFP 50-52, FFP 54-54,
ISIP 1112, FSIP 1021, HP 2268, 120°.

CASING RECORD

[ ] New [ ] Used

Report all strings set-conductor, surface, intermediate, production, etc.

Table with columns: Purpose of String, Size Hole Drilled, Size Casing Set (In O.D.), Weight Lbs./Ft., Setting Depth, Type of Cement, # Sacks Used, Type and Percent Additives. Row 1: Surface, 12 1/4", 8 5/8", 20# & 24#, 365, 60/40 Poz, 200, 2% Gel, 3% CC.

PERFORATION RECORD

Shots Per Foot Specify Footage of Each Interval Perforated

Acid, Fracture, Shot, Cement Squeeze Record (Amount and Kind of Material Used) Depth

Table for Perforation Record with multiple rows for recording data.

TUBING RECORD

Size Set At Packer At Liner Run [ ] Yes [ ] No

Table with columns: Date of First Production, Producing Method, Estimated Production Per 24 Hours, Oil Bbls., Gas Mcf, Water Bbls., Gas-Oil Ratio, Gravity.

Disposition of Gas:

METHOD OF COMPLETION

Production Interval

[ ] Vented [ ] Sold [ ] Used on Lease (If vented, submit ACO-18.)
[ ] Open Hole [ ] Perforation [ ] Dually Completed [ ] Commingled
[ ] Other (Specify)

ORIGINAL

8-17-90  
9-19-91

DRILLER'S WELL LOG

15-171-20390-0000

DATE COMMENCED: 8-2-89  
DATE COMPLETED: 8-10-89

SLAWSON EXPLORATION COMPANY, INC.  
CARSON "T" #1  
SW NW Sec. 4-18S-31W  
SCOTT COUNTY, KS.

0 - 365 Shale & Sand  
365 - 510 Clay & Shale  
510 - 872 Shale  
1877 - 2047 Sand  
2047 - 2270 Shale  
2301 - 2320 Anhy  
2320 - 4650 Lime & Shale

ELEVATION: 2958 GR 2963 KB

FORMATION DATA: Sample

ANHY 2300 (+663)  
Base Anhy 2320 (+643)  
TOP 3678 (-715)  
HEEB 3907 (-944)  
LANS 3949 (-986)  
MUN CR 4126 (-1163)  
STK 4224 (-1261)  
BKC 4306 (-1343)  
PLEAS 4313 (-1350)  
ALT B 4375 (-1412)  
PAW 4436 (-1473)  
RTD 4650 (-1687)

REMOVED

8 1

FROM CONFIDENTIAL

SURFACE CASING:

8 5/8" set @ 365 W/200 sx. 60/40  
Pozmix, 2% Gel, 3% CC

A F F I D A V I T

STATE OF KANSAS )  
COUNTY OF BARTON) ss


GREG DAVIDSON of lawful age, does swear and state that the facts and statements herein are true and correct to the best of his knowledge.

AUG 25 1989  
KANSAS GEOLOGICAL SURVEY  
WICHITA BRANCH

AUG 17 1989

Greg Davidson  
Greg Davidson

Subscribed and sworn to before me this 16th day of August, 1989.

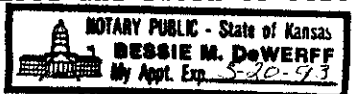

My Commission expires: 5-20-93

Bessie M. DeWerff  
Notary Public: Bessie M. DeWerff