


STATE OF KANSAS  
STATE CORPORATION COMMISSION

Form CP-4

Give All Information Completely  
Make Required Affidavit  
Mail or Deliver Report to:  
Conservation Division  
State Corporation Commission  
212 No. Market  
Wichita, Kansas

WELL PLUGGING RECORD

NORTH

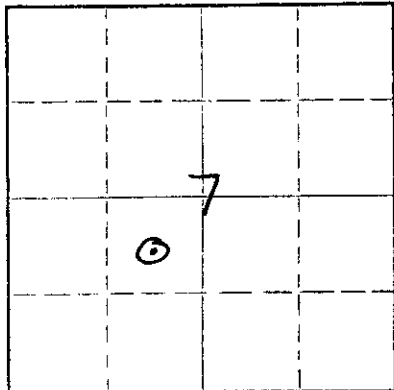

Locate well correctly on above  
Section Plat

Wichita County, Sec. 7 Twp. 19s Rge. (E) 36 (W)  
Location as "NE/CNW/SW" or footage from lines C-NE-SW  
Lease Owner Shenandoah Oil Corporation  
Lease Name Willis Trust Well No.  
Office Address 230 Hightower Bldg., Oklahoma City, Oklahoma 73102  
Character of Well (completed as Oil, Gas or Dry Hole) Dry Hole  
Date well completed 3-19-75 19  
Application for plugging filed 3-19-75 19  
Application for plugging approved 3-19-75 19  
Plugging commenced 3-19-75 19  
Plugging completed 3-20-75 19  
Reason for abandonment of well or producing formation Dry Hole

If a producing well is abandoned, date of last production NONE 19  
Was permission obtained from the Conservation Division or its agents before plugging was commenced? YES

Name of Conservation Agent who supervised plugging of this well Gilbert Balthouzaur  
Producing formation NONE Depth to top ----- Bottom ----- Total Depth of Well 5030 Feet  
Show depth and thickness of all water, oil and gas formations.

OIL, GAS OR WATER RECORDS

CASING RECORD

FORMATION	CONTENT	FROM	TO	SIZE	PUT IN	PULLED OUT
NONE		Surface	389'	8 5/8	389	-0-

Describe in detail the manner in which the well was plugged, indicating where the mud fluid was placed and the method or methods used in introducing it into the hole. If cement or other plugs were used, state the character of same and depth placed, from \_\_\_\_\_ feet to \_\_\_\_\_ feet for each plug set.

All cement plugs pumped thru drill pipe as follows:  
Heavy mud from 5030 to 1110'  
70 sxs common cement 1100' to 900'  
Heavy mud from 900' to 410'  
20 sx common cement from 410' to 350'  
Heavy Mud from 350 to 40'  
10 sx common cement from 40' to 10'  
Cut off 8 5/8" surface csg 3' below ground level  
Weld on steel plate - Job complete 1:30 a.m. 3-20-75

RECEIVED  
STATE CORPORATION COMMISSION  
APR 1 1975  
4-1-75  
CONSERVATION DIVISION  
Wichita, Kansas

(If additional description is necessary, use BACK of this sheet)

Name of Plugging Contractor Jim Snyder Drilling Company  
Address Denver Club Bldg., Denver, Colorado

STATE OF \_\_\_\_\_, COUNTY OF \_\_\_\_\_, ss. \_\_\_\_\_ (employee of owner) or (owner or operator) of the above-described well, being first duly sworn on oath, says: That I have knowledge of the facts, statements, and matters herein contained and the log of the above-described well as filed and that the same are true and correct. So help me God.

(Signature) Donald F. Nowak Donald F. Nowak  
230 Hightower Bldg., Okla. City, Okla. 73102  
(Address)

SUBSCRIBED AND SWORN to before me this 31st day of March, 1975

My commission expires January 3, 1979  
Mary M. Pulliam  
Notary Public.

Shenandoah Oil Corporation

April 15, 1975

#1 Willis  
C-NE $\frac{1}{4}$  SW $\frac{1}{4}$  Section 7-T19S-R36W  
Wichita County, Kansas

RECEIVED  
OKLA CITY,  
APR 23 1975

- 0 - 125', sand
- 125' - 389', sand and shale
- 390' - 975' shale and shells
- 975' -1420', shale
- 1420' -2020', shale, lime and salt
- 2020' -2445', shale and shells
- 2445' -2920', shale and sand
- 2920' - 3105', lime
- 3105' -3365', shale and lime
- 3365' -3495', lime
- 3495' -3742', shale and lime
- 3742' -3798', lime
- 3798' -4027', lime and shale
- 4027' -4130', lime
- 4130' -4325', lime and shale
- 4325' - 4410', lime
- 4410' -4480', lime and chalk
- 4480' -4550', lime and shale
- 4550' - 4749', lime
- 4749' -4839', lime, chalk and shale
- 4839' - 4969', shale and lime
- 4969' -5030', lime

RECEIVED  
MAY 7 1975

I CERTIFY THAT THE ABOVE SAMPLE DESCRIPTION IS A TRUE AND COMPLETE RECORD OF THE FORMATIONS ENCOUNTERED IN DRILLING THE CAPTIONED WELL AS TAKEN FROM THE DAILY DRILLING REPORTS OF JIM SNYDER DRILLING COMPANY.

JIM SNYDER DRILLING COMPANY

By: Fran Rovlenchik  
Fran Rovlenchik