

STATE OF KANSAS
STATE CORPORATION COMMISSION

Form CP-4

Give All Information Completely
Make Required Affidavit
Mail or Deliver Report to:
Conservation Division
State Corporation Commission
212 No. Market
Wichita, Kansas 67202

WELL PLUGGING RECORD

Wichita County, Sec. 35 Twp. 18s Rge. (E) 37 (W)

Location as "NE/CNW/SW" or footage from lines 330' E of C N/2

Lease Owner Shenandoah Oil Corporation

Lease Name Radna Nance Well No. #1

Office Address 230 Hightower Bldg., Oklahoma City, Oklahoma 73102

Character of Well (completed as Oil, Gas or Dry Hole) Dry Hole - Gas

Date well completed April 12, 19 75

Application for plugging filed April 14, 19 75

Application for plugging approved April 15, 19 75


Plugging commenced April 24, 19 75

Plugging completed April 26, 19 75

Reason for abandonment of well or producing formation No Commercial Production

If a producing well is abandoned, date of last production NONE 19

Was permission obtained from the Conservation Division or its agents before plugging was commenced? Yes

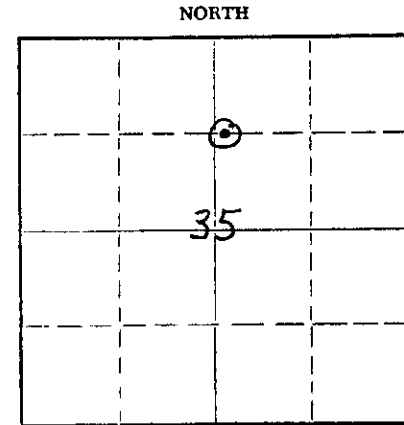

Locate well correctly on above Section Plat

Name of Conservation Agent who supervised plugging of this well Gilbert Balthouzar

Producing formation NONE Depth to top --- Bottom --- Total Depth of Well 3060 Feet

Show depth and thickness of all water, oil and gas formations.

OIL, GAS OR WATER RECORDS

CASING RECORD

FORMATION	CONTENT	FROM	TO	SIZE	PUT IN	PULLED OUT
		0	341'	8 5/8 OD	341'	NONE
		0	3060	4 1/2 OD	3060'	2360'

Describe in detail the manner in which the well was plugged, indicating where the mud fluid was placed and the method or methods used in introducing it into the hole. If cement or other plugs were used, state the character of same and depth placed, from feet to feet for each plug set.

Mixed and pumped 35 sx common cement. Cement plug inside 3 1/2 csg. 2760 to 2360' cement displaced with heavy mud.
Cut off 4 1/2 casing at 2350'. pulled casing to 800'
Mixed and pumped 35 sx common cement. Cement plug 800 to 700'. Pulled casing to 350'
Heavy mud from 700 to 350'. Mixed and pumped 35 sx common cement. Cement plug.
From 350' to 250'. Heavy mud from 250' to 45' to 3'. Cut off 8 5/8" casing
3' Below ground level. Welded on steel plate. Job complete 3:45 p.m. 4-26-75

5-12-75

(If additional description is necessary, use BACK of this sheet)

Name of Plugging Contractor Sargents Casing Pullers
Address P.O. Box 506 Liberal Kansas 67901

STATE OF _____, COUNTY OF _____, ss.

_____, (employee of owner) or (owner or operator) of the above-described well, being first duly sworn on oath, says: That I have knowledge of the facts, statements, and matters herein contained and the log of the above-described well as filed and that the same are true and correct. So help me God.

(Signature) Donald F. Nance
230 Hightower Bldg., Oklahoma City, OK 73102
(Address)

SUBSCRIBED AND SWORN TO before me this 5th day of May, 1975

My commission expires Sept 17, 1975 Notary Public.

EFFECTIVE DATE: 4-7-93
DISTRICT # _____
TSA? Yes No

State of Kansas
NOTICE OF INTENTION TO DRILL 203-20,100-0000
FORM MUST BE SIGNED
ALL BLANKS MUST BE FILLED

Must be approved by the K.C.C. five (5) days prior to commencing well

Expected Spud Date: 4 month 5 day 93 year
Location: 150 ^{Spot} SE of SE SW Sec 15 Twp 18 S. Rg 38 East West

OPERATOR: License # 5316
Name: Falcon Exploration, Inc.
Address: 155 N. Market, #1010
City/State/Zip: Wichita, KS 67202-1824
Contact Person: Jim Thatcher
Phone: (316) 265-3351

CONTRACTOR: License # 30684
Name: Abercrombie

550 feet from South ~~XXXX~~ line of Section
3190 feet from East ~~XXXX~~ line of Section
IS SECTION REGULAR IRREGULAR

(NOTE: Locate well on the Section Plat on Reverse Side)
County: Wichita
Lease Name: Oldham Well #: 2
Field Name: Wildcat
Is this a Prorated/Spaced Field? ... yes no
Target Formation(s): Mississippi
Nearest lease or unit boundary: 330'
Ground Surface Elevation: EST. 3394' feet MSL
Water well within one-quarter mile: ... yes no
Public water supply well within one mile: ... yes no
Depth to bottom of fresh water: 200'
Depth to bottom of usable water: 1480'
Surface Pipe by Alternate: ... 1 2
Length of Surface Pipe Planned to be set: (360') 240'
Length of Conductor pipe required: None
Projected Total Depth: 5100'
Formation at Total Depth: Mississippi
Water Source for Drilling Operations:
... well farm pond other
DWR Permit #: _____
Will Cores Be Taken? ... yes no
If yes, proposed zone: _____

Well Drilled For:	Well Class:	Type Equipment:
<input checked="" type="checkbox"/> Oil	... Enh Rec	... Infield <input checked="" type="checkbox"/> Mud Rotary
... Gas	... Storage	... Pool Ext. <input type="checkbox"/> Air Rotary
... OUVG	... Disposal	<input checked="" type="checkbox"/> Wildcat <input type="checkbox"/> Cable
... Seismic	... # of Holes	... Other
... Other		

If OUVG: old well information as follows:
Operator: _____
Well Name: _____
Comp. Date: _____ Old Total Depth _____

Directional, Deviated or Horizontal wellbores? ... yes no
If yes, true vertical depth: _____
Bottom Hole Location: _____

AFFIDAVIT

240' Alt. II Req.

Exp. 10/2/93

The undersigned hereby affirms that the drilling, completion and eventual plugging of this well will comply with K.S.A. 55-101, et. seq.
It is agreed that the following minimum requirements will be set:

Pusher Harold
SPUD DATE 4-10-93 INIT. CM
LENGTH SURFACE PLANNED 320 ±
RESERVE PIT STATUS- REMOVE FLUID LINED
after salt sect. bbls. when done bbls.
RATHOLE AHEAD? Y N SIZE HOLE _____
SURFACE PIPE 3 1/2" @ 349 CONDUCTOR _____
ANHYDRITE T-202 B-202 ELEVATION _____
TD 5498 FORMATION Miss
RAN PIPE @ _____ DV TOOL _____ ALT II DONE _____
_____ SX _____ Y _____ N _____
_____ Arbuckle Plug @ _____ Ft. W/ _____ SX
_____ Hug./Council @ _____ Ft. W/ _____ SX
_____ Anhydrite Base @ 2550 Ft. W/ 50 SX
_____ 1/2 Base Anyh. @ 1500 Ft. W/ 50 SX
_____ 1/2, 1/2 Plug @ 750 Ft. W/ 50 SX
_____ Bottom Surface @ 770 Ft. W/ 50 SX
_____ 40' Plug @ 40 Ft. W/ 10 SX
RAT HOLE CIRC/W 1 1/2 SX MOUSE HOLE W/ _____ SX
WATER WELL _____ SX (Irr. Well _____ Pond _____)
Hauling _____
TECHNICIAN _____ DATE _____
TYPE OF CEMENT _____
STARTING TIME 10:30 (AM) DATE 5-8-93
COMPLETION TIME 12:30 (AM) DATE 5-8-93
CEMENT COMPANY Alfred