

Give All Information Completely
Make Required Affidavit
Mail or Deliver Report to:
Conservation Division
State Corporation Commission
212 North Market, Insurance Bldg.
Wichita, Kansas

WELL PLUGGING RECORD

Finney County, Sec. 33 Twp. 21 Rge. 32 (E) (W)

Location as "NE/CNW/SW" or footage from lines. SE 1/4

Lease Owner Lawson Petroleum Company-2100 Philtower Bldg, Tulsa, Okl

Lease Name Laudgraf Well No. # 1

Office Address Mr. Elwayne Brady Box 302 Garden City, Kansas

Character of Well (completed as Oil, Gas or Dry Hole) _____

Date well completed _____ 19__

Application for plugging filed yes 19__

Application for plugging approved yes 19__


Plugging commenced 2-17-61. 19__

Plugging completed 2-18-61. 19__

Reason for abandonment of well or producing formation _____

If a producing well is abandoned, date of last production _____ 19__

Was permission obtained from the Conservation Division or its agents before plugging was commenced? yes

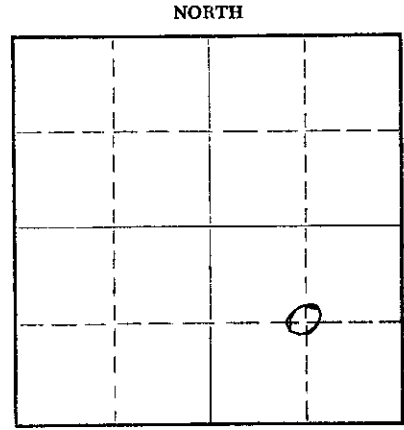

Locate well correctly on above Section Plat

Name of Conservation Agent who supervised plugging of this well Frank Broadfoot

Producing formation _____ Depth to top _____ Bottom _____ Total Depth of Well 2711' Feet

Show depth and thickness of all water, oil and gas formations.

OIL, GAS OR WATER RECORDS

CASING RECORD

FORMATION	CONTENT	FROM	TO	SIZE	PUT IN	PULLED OUT
						no recovery.

Describe in detail the manner in which the well was plugged, indicating where the mud fluid was placed and the method or methods used in introducing it into the hole. If cement or other plugs were used, state the character of same and depth placed, from _____ feet to _____ feet for each plug set.

Plugging commenced 2-17-61. Plugging completed 2-18-61.

Measured in to total depth: 2711'.

Plugged off bottom: Sanded back to 2660' and dumped 5 sacks of cement. Mudded hole up to 400'.

Set a rock bridge at 400' and dumped 10 sacks of cement. Mudded hole up to 35' and set a rockbridge and capped the well with 5 sacks of cement.

(If additional description is necessary, use BACK of this sheet)

Name of Plugging Contractor J. O. Forbes d/b/a Forbes Casing Pulling Company

Address P. O. Box 221 Great Bend, Kansas

STATE OF Kansas, COUNTY OF Barton, ss. J. O. Forbes

(employee of owner) or (owner or operator) of the above-described well, being first duly sworn on oath, says: That I have knowledge of the facts, statements, and matters herein contained and the log of the above-described well as filed and that the same are true and correct. So help me God.

(Signature) J. O. Forbes
Great Bend, Kansas
(Address)

SUBSCRIBED AND SWORN TO before me this 20th day of February, 19 61

My commission expires December 8th, 1963

Maryann Jenkins Notary Public.



STATE CORPORATION COMMISSION

1961

CONSERVATION DIVISION
Wichita, Kansas