


STATE OF KANSAS
STATE CORPORATION COMMISSION

Form CP-4

Give All Information Completely
Make Required Affidavit
Mail or Deliver Report to:
Conservation Division
State Corporation Commission
211 No. Broadway
Wichita, Kansas

WELL PLUGGING RECORD

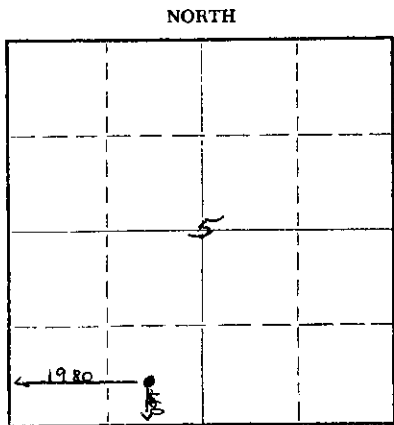

Finney County, Sec. 5 Twp. 22S Rge. 32W (E) (W)
Location as "NE/CNW/SW" or footage from lines SE SW
Lease Owner Amarillo Natural Gas Company
Lease Name Greathouse #1 Well No. 1
Office Address 305 Bank of the Southwest Bldg., Amarillo, Texas
Character of Well (completed as Oil, Gas or Dry Hole) Dry Hole
Date well completed 9-15 19 66
Application for plugging filed 9-15 19 66
Application for plugging approved 9-15 19 66
Plugging commenced 9-15 19 66
Plugging completed 9-16 19 66
Reason for abandonment of well or producing formation _____

If a producing well is abandoned, date of last production _____ 19 ____
Was permission obtained from the Conservation Division or its agents before plugging was commenced? Yes

Name of Conservation Agent who supervised plugging of this well Edgar Eyes
Producing formation _____ Depth to top _____ Bottom _____ Total Depth of Well 4950 Feet
Show depth and thickness of all water, oil and gas formations.


OIL, GAS OR WATER RECORDS

CASING RECORD

FORMATION	CONTENT	FROM	TO	SIZE	PUT IN	PULLED OUT
Surface Pipe	8 5/8	0	382	8 5/8	382	-0-

Describe in detail the manner in which the well was plugged, indicating where the mud fluid was placed and the method or methods used in introducing it into the hole. If cement or other plugs were used, state the character of same and depth placed, from 700 feet to _____ feet for each plug set.

435 to 330 35 Sx Spotted to Drill Pipe by Sun Cementing Co.
40 to -0- 15 Sx

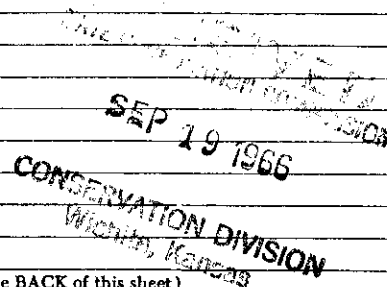

(If additional description is necessary, use BACK of this sheet)
Name of Plugging Contractor Mahoney Drilling Co., Inc.
Address Box 1257, Liberal, Kansas

STATE OF Kansas, COUNTY OF Seward, ss.
T. W. Mahoney (employee of owner) or (owner or operator) of the above-described well, being first duly sworn on oath, says: That I have knowledge of the facts, statements, and matters herein contained and the log of the above-described well as filed and that the same are true and correct. So help me God.

(Signature) T. W. Mahoney
(Address) _____

SUBSCRIBED AND SWORN TO before me this 16 day of September, 1966

My commission expires January 24, 1968

George W. Carmichael Jr Notary Public.



DRILLING LOG

LEASE OWNER Amarillo Natural Gas Co. ADDRESS 305 Bank of the Southwest Bldg.
Amarillo, Texas
LEASE Greathouse #1 COUNTY Finney, Kansas DESCRIPTION SE SW Sec. 5-22S-32W

CASING: SIZE 8 5/8 WEIGHT 20 AMOUNT 382

CEMENT: AMOUNT 425 Sx. CIRCULATED: Yes X No

RECEIVED
STATE CONSERVATION COMMISSION

SEP 19 1966

CASING: SIZE _____ WEIGHT _____ AMOUNT _____

CEMENT: AMOUNT _____ Sx. CIRCULATED: Yes _____ No

CONSERVATION DIVISION
Wichita, Kansas

PLUG SET: 435 Ft. TO 330 Ft. CEMENT 35 Sx.

40 Ft. TO -0- Ft. CEMENT 15 Sx.

FORMATION AND DEPTH

<u>Sand Gyp</u>	<u>0</u>	TO	<u>389</u>
<u>Sand & Shale</u>	<u>389</u>	TO	<u>2015</u>
<u>Shale & Anhydrite</u>	<u>2015</u>	TO	<u>2220</u>
<u>Shale & Lime</u>	<u>2220</u>	TO	<u>3952</u>
<u>Lime</u>	<u>3952</u>	TO	<u>4025</u>
<u>Lime & Shale</u>	<u>4025</u>	TO	<u>4145</u>
<u>Lime</u>	<u>4145</u>	TO	<u>4950</u>
<u>TD</u>	<u>4950</u>	TO	
		TO	
		TO	
		TO	
		TO	
		TO	
		TO	
		TO	
		TO	

THIS IS A TRUE AND EXACT COPY OF THE FORMATIONS TAKEN FROM THE DAILY DRILLING REPORTS.

Executed this 16th day of September 19 66

By A. W. Mahoney

IN WITNESS WHEREOF, I have hereunto set my hand and affixed my official seal the day and year above written.

George W. Carnahan Jr
Notary Public

MY COMMISSION EXPIRES: January 24, 1966