

Give All Information Completely
Make Required Affidavit
Mail or Deliver Report to:
Conservation Division
State Corporation Commission
211 No. Broadway
Wichita, Kansas

WELL PLUGGING RECORD

Finney County, Sec. 12 Twp. 22S Rge. 32W (E) (W)

Location as "NE/CNW/SW" or footage from lines Ctr SW/4

Lease Owner Texaco Inc.

Lease Name Ed Hughes "C" Unit Well No. 1

Office Address 614 Bitting Building, Wichita, Kansas

Character of Well (completed as Oil, Gas or Dry Hole) Dry Hole

Date well completed 6-5 19 59

Application for plugging filed 2-18 19 63

Application for plugging approved 2-20 19 63


Plugging commenced 2-21 19 63

Plugging completed 2-21 19 63

Reason for abandonment of well or producing formation Dry Hole

If a producing well is abandoned, date of last production Dry Hole 19

Was permission obtained from the Conservation Division or its agents before plugging was commenced? Yes

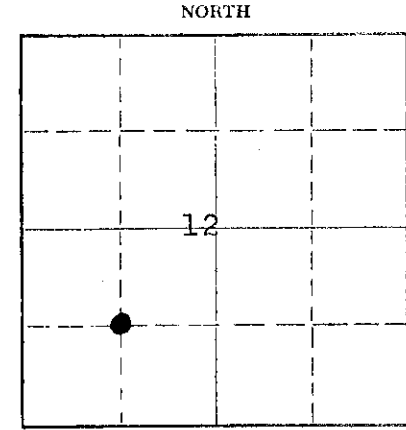

Locate well correctly on above Section Plat

Name of Conservation Agent who supervised plugging of this well Hugh Scott

Producing formation _____ Depth to top _____ Bottom _____ Total Depth of Well _____ Feet

Show depth and thickness of all water, oil and gas formations.

OIL, GAS OR WATER RECORDS

CASING RECORD

FORMATION	CONTENT	FROM	TO	SIZE	PUT IN	PULLED OUT
Dry Hole				7-5/8"	198	None
				4-1/2"	2771	None

Describe in detail the manner in which the well was plugged, indicating where the mud fluid was placed and the method or methods used in introducing it into the hole. If cement or other plugs were used, state the character of same and depth placed, from _____ feet to _____ feet for each plug set.

Hole plugged as follows: Heavy mud 2705-700', 50 sacks cement 700'-3'.

RECEIVED

FEB 27 1963

CONSERVATION DIVISION
Wichita, Kansas

(If additional description is necessary, use BACK of this sheet)

Name of Plugging Contractor None

Address _____

STATE OF Kansas, COUNTY OF Sedgwick, ss.
H. N. Wade (employee of owner) or (owner or operator) of the above-described

well, being first duly sworn on oath, says: That I have knowledge of the facts, statements, and matters herein contained and the log of the above-described well as filed and that the same are true and correct. So help me God.

(Signature) *H. N. Wade*

614 Bitting Bldg., Wichita, Kansas
(Address)

SUBSCRIBED AND SWORN TO before me this 26th day of February, 19 63

My Commission Expires April 1, 1963

My commission expires _____

Lila J. Good
Notary Public.



WELL LOG

15-055-00234-0000

COMPANY **TEXACO, INCORPORATED**

SEC 12 T. 22S. R. 32W

FARM **ED HUGHES UNIT "C" 1**

C-SW/4


TOTAL DEPTH **2771'**

COUNTY **FINNEY CO., KANSAS**

COMM. **May 19, 1959**

COMP. **May 24, 1959**

CONTRACTOR **GARVEY DRILLING COMPANY**

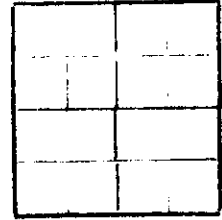

CASING **7 5/8" @ 193' W/200 sax.
4 1/2" @ 2771' W/250 sax.**

ELEVATION

PRODUCTION

INDICATE BOTTOM OF FORMATIONS

RECEIVED
STATE CORPORATION COMMISSION

FEB 20 1963

CONSERVATION DIVISION
Wichita, Kansas

40	Surface clay
165	Clay, sand & gravel
450	Shale
475	Sand
800	Blue shale
965	Shale
1395	Shale & shells
1630	Shale
1845	Glorietta sand
2295	Shale
2485	Shale & lime
2510	Lime & shale
2690	Lime, shale & sand
2771	Lime
2771	T. D.

State of **KANSAS**

County of **BARION**

I, **VERNE A. MORRIS**

of

GARVEY DRILLING COMPANY

do hereby state that the above and foregoing is a true and correct copy of the log of the **#1 ED HUGHES "C" UNIT**

Verne A. Morris

Subscribed and sworn to before me this **28th** day of **May** 19 **59**

My Commission Expires **November 12, 1962**

[Signature]
NOTARY PUBLIC