

WELL PLUGGING RECORD

Give All Information Completely
Make Required Affidavit
Mail or Deliver Report to:
Conservation Division
State Corporation Commission
211 No. Broadway
Wichita, Kansas

Finney County, Sec. 9 Twp 25S Rge. 31W(E) (W)

Location as "NE/CNW/SW" or footage from lines C/SE/4-NW/4

Lease Owner Apache Corporation

Lease Name Reed Unit Well No. 1

Office Address 823 South Detroit, Tulsa 20, Oklahoma

Character of Well (completed as Oil, Gas or Dry Hole) Dry Hole

Date well completed April 13 19 62

Application for plugging filed April 12 19 62

Application for plugging approved April 12 19 62


Plugging commenced April 13 19 62

Plugging completed April 13 19 62

Reason for abandonment of well or producing formation Dry hole

If a producing well is abandoned, date of last production No production 19

Was permission obtained from the Conservation Division or its agents before plugging was commenced? Yes

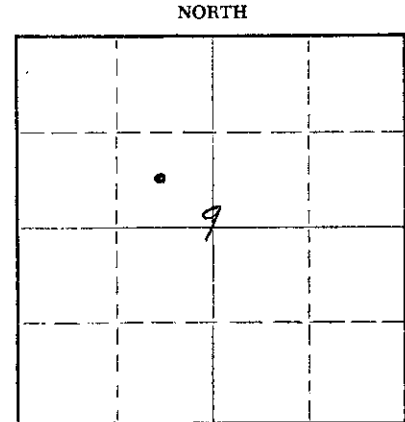

Locate well correctly on above Section Plat

Name of Conservation Agent who supervised plugging of this well Mr. Victor Simonic

Producing formation No production Depth to top Bottom Total Depth of Well Feet

Show depth and thickness of all water, oil and gas formations.

OIL, GAS OR WATER RECORDS

CASING RECORD

FORMATION	CONTENT	FROM	TO	SIZE	PUT IN	PULLED OUT
Surface soil, clay & shale	Surface csg	0	357	8-5/8	357	None
Dakota		382				
Glorieta		1519				
Kreider		2545	2559			
Winfield		2573	2600			

Describe in detail the manner in which the well was plugged, indicating where the mud fluid was placed and the method or methods used in introducing it into the hole. If cement or other plugs were used, state the character of same and depth placed, from feet to feet for each plug set.

Filled hole with heavy mud laden fluid thru drill pipe & spotted a 40-sack cement plug @ 2600 to 2500'; a 40-sack plug was placed across bottom of surface casing, 420' to 288' and the surface casing was capped with 10 sacks, 30 to 10'.

RECEIVED
STATE CORPORATION COMMISSION

APR 13 1962

CONSERVATION DIVISION

(If additional description is necessary, use BACK of this sheet)

Name of Plugging Contractor Prime Drilling Company

Address Union Center Building, Wichita, Kansas

STATE OF Oklahoma, COUNTY OF Tulsa, ss. Marcus Hoppes

(employee of owner) or (owner or operator) of the above-described well, being first duly sworn on oath, says: That I have knowledge of the facts, statements, and matters herein contained and the log of the above-described well as filed and that the same are true and correct. So help me God.

(Signature) Marcus Hoppes
823 South Detroit, Tulsa 20, Oklahoma (Address)

SUBSCRIBED AND SWORN TO before me this 30 day of April, 19 62

LAWRENCE A. GATZ, Notary Public
In and for the State of Oklahoma
My Commission Expires January 7, 1963

Lawrence A. Gatz
Notary Public.

My commission expires



ROTARY DRILLING LOG

OPERATOR: Apache Corporation,
REED UNIT #1,
 C/ SE NW Sec. 9-25S-31W,
 Finney County, Kansas.

CONTRACTOR: Prime Drilling Company
 COMM: 4-5-62
 COMP: 4-13-62

Remarks: Set 8-5/8" surface casing at 357'
 w/ 250 sx. Pozmix HA 5.

Formations:

Sand	250'
Clay Shale	357'
Shale	904'
Shale & Red Bed	1265'
Shale & Shells	1620'
Shale	1853'
Shale & Lime	1965'
Lime	2215'
Shale	2303'
Shale & Lime	2370'
Lime	2452'
Lime & Shale	2569'
Lime	2600'
Rotary Total Depth D & A	2600'

We certify the above log is true and correct to the best of our knowledge and belief.

PRIME DRILLING COMPANY

By

R. R. McNicol

R. R. McNicol

RECEIVED
 STATE CORPORATION COMMISSION

MAY 9 1962

CONSERVATION DIVISION
 Wichita, Kansas