



CONFIDENTIAL

WELL COMPLETION FORM

Form Must Be Typed
Form must be Signed
All blanks must be Filled

WELL HISTORY - DESCRIPTION OF WELL & LEASE

OPERATOR: License # 34192
Name: SandRidge Exploration and Production LLC
Address 1: 123 ROBERT S. KERR AVE
Address 2:
City: OKLAHOMA CITY State: OK Zip: 73102 + 6406
Contact Person: Tiffany Golay
Phone: (405) 429-6543
CONTRACTOR: License # 34464
Name: Lariat Services, Inc.
Wellsite Geologist: Tammy Alcorn
Purchaser: Atlas (gas) Plains Marketing, LP (oil)

API No. 15 - 15-077-21858-01-00
Spot Description:
S2 S2 SW SW Sec. 32 Twp. 32 S. R. 6 East West
200 Feet from North / South Line of Section
660 Feet from East / West Line of Section

Footages Calculated from Nearest Outside Section Corner:
 NE NW SE SW

County: Harper
Lease Name: Lillian 3206 Well #: 1-32H

Field Name:
Producing Formation: Mississippian
Elevation: Ground: 1381 Kelly Bushing: 1401

Total Depth: 8865 Plug Back Total Depth:
Amount of Surface Pipe Set and Cemented at: 745 Feet
Multiple Stage Cementing Collar Used? Yes No
If yes, show depth set: Feet
If Alternate II completion, cement circulated from:
feet depth to: w/ sx cmt.

Drilling Fluid Management Plan
(Data must be collected from the Reserve Pit)

Chloride content: 12000 ppm Fluid volume: 8600 bbls
Dewatering method used: Haul Off Pit

Location of fluid disposal if hauled offsite:

Operator Name: Soil Farm Co: Mudslingers LLC
Lease Name: Unnamed License #: 00000

Quarter SE Sec. 6 Twp. 28 S. R. 6 East West
County: Grant, OK Permit #: 12-20710

Designate Type of Completion:
 New Well Re-Entry Workover
 Oil WSW SWD SIOW
 Gas D&A ENHR SIGW
 OG GSW Temp. Abd.
 CM (Coal Bed Methane)
 Cathodic Other (Core. Expl., etc.):

If Workover/Re-entry: Old Well Info as follows:
Operator:

Well Name:

Original Comp. Date: Original Total Depth:
 Deepening Re-perf. Conv. to ENHR Conv. to SWD
 Conv. to GSW
 Plug Back: Plug Back Total Depth
 Commingled Permit #:
 Dual Completion Permit #:
 SWD Permit #:
 ENHR Permit #:
 GSW Permit #:

6/25/2012 7/22/2012 7/25/2012
Spud Date or Date Reached TD Completion Date or Recompletion Date

AFFIDAVIT

I am the affiant and I hereby certify that all requirements of the statutes, rules and regulations promulgated to regulate the oil and gas industry have been fully complied with and the statements herein are complete and correct to the best of my knowledge.

Submitted Electronically

KCC Office Use ONLY

Letter of Confidentiality Received
Date: 10/23/2012
 Confidential Release Date:
 Wireline Log Received
 Geologist Report Received
 UIC Distribution
ALT I II III Approved by: NAOMI JAMES Date: 10/26/2012



123 Robert S. Kerr Ave.
Oklahoma City, OK 73102

Survey
LILLIAN 3206 1-32H

Step #1 - Create a Deviation Survey

Step

#2 - Attach the survey "Description" to the Wellbore - Deviation Survey

Wellbores - Step #2

Actual Deviation Survey	Wellbore Name
Wireline, Proposed? No	Original Hole

Deviation Surveys - Step #1

Description	Date	VS Dir (°)	Comment
Wireline	7/8/2012		

Tie-in Data

Azimuth North Type	Convergency (")	Declination (")	MD Tie In (ftKB)	Azimuth Tie In (")	Inclination Tie In (")	TVD Tie In (ftKB)	NSTie In (ft)	EW Tie In (ft)
		0.75						

Survey Data

MD (ftKB)	Incl (")	Azm (")	Survey Company	Method	TVD (ftKB)	VS (ft)	NS (ft)	EW (ft)	DLS (°/100ft)
250	0.8	357.60	Rig	Incl	250	2	1.63	-0.07	0.30
520	1.0	357.60	Rig	Incl	520	6	5.75	-0.24	0.09
720	1.0	357.60	Rig	Incl	720	9	9.15	-0.38	0.03
934	0.9	357.60	Rig	Incl	934	13	12.61	-0.53	0.02
1,410	1.2	5.90	DrillRight	Incl	1,410	21	21.30	-0.17	0.07
1,887	0.8	327.70	DrillRight	Incl	1,887	29	29.08	-1.44	0.16
2,363	0.1	346.30	DrillRight	Incl	2,363	32	32.29	-3.31	0.15
2,363	0.1	346.30	DrillRight	Incl	2,363	32	32.29	-3.31	0.15
2,839	1.5	260.70	DrillRight	Incl	2,839	32	31.89	-9.56	0.31
3,315	1.3	228.10	DrillRight	Incl	3,315	27	27.08	-19.73	0.17
3,557	1.1	228.00	DrillRight	Incl	3,556	24	23.69	-23.50	0.08
3,569	1.2	227.70	DrillRight	Incl	3,568	24	23.53	-23.67	0.83
3,601	0.7	247.50	DrillRight	Incl	3,600	24	23.23	-24.10	1.85
3,633	1.7	342.40	DrillRight	Incl	3,632	24	23.61	-24.43	5.92
3,664	4.3	354.70	DrillRight	Incl	3,663	25	25.20	-24.67	8.59
3,696	7.0	354.30	DrillRight	Incl	3,695	29	28.34	-24.98	8.44
3,728	9.2	356.50	DrillRight	Incl	3,727	33	32.83	-25.33	6.94
3,760	11.5	358.30	DrillRight	Incl	3,758	39	38.57	-25.58	7.26
3,791	13.4	359.70	DrillRight	Incl	3,789	46	45.26	-25.69	6.21
3,823	15.1	0.20	DrillRight	Incl	3,820	53	53.13	-25.69	5.33
3,855	16.8	359.20	DrillRight	Incl	3,850	62	61.93	-25.74	5.38
3,887	18.8	358.90	DrillRight	Incl	3,881	72	71.71	-25.91	6.26
3,918	21.2	358.80	DrillRight	Incl	3,910	83	82.31	-26.12	7.74
3,950	24.1	359.60	DrillRight	Incl	3,940	95	94.63	-26.29	9.11
3,982	26.6	359.80	DrillRight	Incl	3,969	109	108.33	-26.36	7.82
4,014	29.0	0.90	DrillRight	Incl	3,997	124	123.25	-26.26	7.67
4,045	31.7	1.90	DrillRight	Incl	4,024	139	138.90	-25.87	8.86
4,077	34.1	1.80	DrillRight	Incl	4,050	157	156.28	-25.31	7.50
4,109	36.3	1.80	DrillRight	Incl	4,077	175	174.71	-24.73	6.87
4,141	38.6	2.10	DrillRight	Incl	4,102	194	194.16	-24.07	7.21
4,172	40.9	2.30	DrillRight	Incl	4,126	214	213.96	-23.31	7.43
4,204	43.1	2.20	DrillRight	Incl	4,160	236	235.36	-22.47	6.88
4,236	45.9	2.60	DrillRight	Incl	4,172	258	257.77	-21.53	8.79
4,268	48.1	2.40	DrillRight	Incl	4,194	281	281.14	-20.51	6.89
4,299	49.7	2.60	DrillRight	Incl	4,215	305	304.48	-19.49	5.18
4,331	49.7	2.60	DrillRight	Incl	4,235	329	328.86	-18.38	0.00
4,395	49.0	2.20	DrillRight	Incl	4,277	378	377.38	-16.35	1.19
4,458	48.3	2.00	DrillRight	Incl	4,319	425	424.64	-14.61	1.14
4,490	47.8	2.10	DrillRight	Incl	4,340	449	448.42	-13.76	1.58
4,522	48.3	2.20	DrillRight	Incl	4,361	472	472.20	-12.87	1.58
4,553	50.9	2.10	DrillRight	Incl	4,382	496	495.79	-11.98	8.39
4,585	53.5	2.10	DrillRight	Incl	4,401	521	521.06	-11.06	8.12
4,617	56.7	2.10	DrillRight	Incl	4,419	547	547.28	-10.10	10.00
4,649	59.8	2.60	DrillRight	Incl	4,436	575	574.47	-8.98	9.78
4,680	63.4	2.30	DrillRight	Incl	4,451	602	601.71	-7.81	11.64



123 Robert S. Kerr Ave.
Oklahoma City, OK 73102

Survey
LILLIAN 3206 1-32H

Step #1 - Create a Deviation Survey

Step

#2 - Attach the survey "Description" to the Wellbore - Deviation Survey

Survey Data

MD (ft)	Incl (°)	Azm (°)	Survey Company	Method	TVD (ft)	VS (ft)	NS (ft)	EW (ft)	DLS (°/100ft)
4,712	66.6	2.20	DrillRight	Incl	4,465	631	630.68	-6.68	10.00
4,744	70.1	1.70	DrillRight	Incl	4,476	660	660.40	-5.67	11.03
4,776	73.6	1.00	DrillRight	Incl	4,486	691	690.80	-4.95	11.13
4,807	77.5	0.60	DrillRight	Incl	4,494	721	720.81	-4.53	12.64
4,839	81.1	0.10	DrillRight	Incl	4,500	752	752.25	-4.34	11.35
4,871	84.9	359.60	DrillRight	Incl	4,504	784	784.00	-4.43	11.98
4,903	88.8	359.10	DrillRight	Incl	4,506	816	815.95	-4.79	12.29
4,926	90.4	358.70	DrillRight	Incl	4,506	839	838.94	-5.23	7.17
4,970	90.2	357.80	DrillRight	Incl	4,506	883	882.92	-6.57	2.10
5,031	90.9	357.40	DrillRight	Incl	4,505	944	943.86	-9.13	1.32
5,093	92.7	358.30	DrillRight	Incl	4,503	1,006	1,005.78	-11.45	3.25
5,153	93.4	358.20	DrillRight	Incl	4,500	1,066	1,065.67	-13.28	1.18
5,215	94.1	357.90	DrillRight	Incl	4,496	1,128	1,127.50	-15.39	1.23
5,276	93.6	357.50	DrillRight	Incl	4,492	1,188	1,188.31	-17.83	1.05
5,370	93.2	358.20	DrillRight	Incl	4,486	1,282	1,282.08	-21.35	0.86
5,465	92.6	359.00	DrillRight	Incl	4,481	1,377	1,376.93	-23.67	1.05
5,580	92.1	359.10	DrillRight	Incl	4,477	1,472	1,471.84	-25.24	0.54
5,655	90.6	359.70	DrillRight	Incl	4,475	1,567	1,566.80	-26.24	1.70
5,750	90.5	359.70	DrillRight	Incl	4,474	1,662	1,661.80	-26.73	0.11
5,845	90.8	359.00	DrillRight	Incl	4,473	1,757	1,756.78	-27.81	0.80
5,940	91.5	359.00	DrillRight	Incl	4,471	1,852	1,851.75	-29.47	0.74
6,036	91.2	359.80	DrillRight	Incl	4,469	1,948	1,947.72	-30.47	0.89
6,131	89.0	358.20	DrillRight	Incl	4,469	2,043	2,042.69	-32.13	2.86
6,226	89.1	359.80	DrillRight	Incl	4,470	2,138	2,137.66	-33.79	1.69
6,321	88.5	360.00	DrillRight	Incl	4,472	2,233	2,232.64	-33.95	0.67
6,416	89.9	1.00	DrillRight	Incl	4,474	2,328	2,327.63	-33.13	1.81
6,511	91.2	1.50	DrillRight	Incl	4,473	2,423	2,422.60	-31.05	1.47
6,607	92.2	360.00	DrillRight	Incl	4,470	2,519	2,518.54	-29.80	1.88
6,638	90.9	359.90	DrillRight	Incl	4,469	2,550	2,549.53	-29.82	4.21
6,702	91.6	359.50	DrillRight	Incl	4,468	2,614	2,613.51	-30.16	1.26
6,797	91.3	359.50	DrillRight	Incl	4,465	2,709	2,708.48	-30.99	0.32
6,893	90.5	358.90	DrillRight	Incl	4,464	2,805	2,804.46	-32.33	1.04
6,987	90.0	358.30	DrillRight	Incl	4,463	2,899	2,898.43	-34.62	0.83
7,082	90.2	357.60	DrillRight	Incl	4,463	2,994	2,993.37	-38.02	0.77
7,177	90.2	357.50	DrillRight	Incl	4,463	3,089	3,088.28	-42.08	0.11
7,237	91.0	358.40	DrillRight	Incl	4,462	3,149	3,148.23	-44.23	2.01
7,300	90.8	359.80	DrillRight	Incl	4,461	3,212	3,211.22	-45.22	2.24
7,395	89.9	360.00	DrillRight	Incl	4,461	3,307	3,306.21	-45.39	0.97
7,490	89.3	359.50	DrillRight	Incl	4,461	3,402	3,401.21	-45.80	0.82
7,585	90.7	359.90	DrillRight	Incl	4,461	3,497	3,496.21	-46.30	1.53
7,712	90.8	0.40	DrillRight	Incl	4,460	3,623	3,623.20	-45.97	0.40
7,806	90.2	0.50	DrillRight	Incl	4,459	3,717	3,717.19	-45.23	0.65
7,901	90.4	0.20	DrillRight	Incl	4,458	3,812	3,812.19	-44.65	0.38
7,996	89.9	359.60	DrillRight	Incl	4,458	3,907	3,907.18	-44.81	0.82
8,092	90.5	359.20	DrillRight	Incl	4,458	4,003	4,003.18	-45.82	0.75
8,187	89.4	359.60	DrillRight	Incl	4,458	4,098	4,098.17	-46.81	1.23
8,282	89.3	359.70	DrillRight	Incl	4,459	4,193	4,193.16	-47.39	0.15
8,377	90.4	359.50	DrillRight	Incl	4,459	4,288	4,288.16	-48.06	1.18
8,472	89.4	359.00	DrillRight	Incl	4,459	4,383	4,383.15	-49.30	1.18
8,567	89.8	358.90	DrillRight	Incl	4,460	4,478	4,478.13	-51.04	0.43
8,662	91.4	0.10	DrillRight	Incl	4,459	4,573	4,573.12	-51.87	2.11

Section 10 32S 6W Section 29 32S 6W Section 28 32S 6W

333' FNL
 BHL: 8,662
 -98.000201, 37.224007

679' FWL
 Bottom Perf: 8,472
 -98.000139, 37.223184

Section 31 32S 6W Section 32 32S 6W Section 3 32S 6W

Top Perf: 4,490
 -98.000144, 37.212486

Miss Entry: 4,458
 -98.000145, 37.212290

LILLIAN 3206 1-32H
 *


FERRIS 1-5H
 *

Section 6 32S 6W Section 5 32S 6W Section 33S 6W



Actual Bottom-Hole Location of Lillian 3206 1-32H
 Harper County, Kansas
 T&R: 32S 6W
 Section: 32, 333' FNL & 679' FWL
 Long Lat: -98.000201, 37.224007

1 in = 735 ft

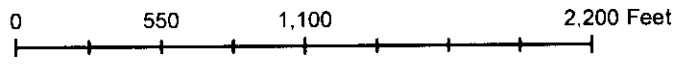

- Actual BH Location
- * SandRidge Wells
- Sections

Draftsman: Aaron Birk	Draft Date: 10/23/2011
Drawing Name/Number: Addendum_Lillian_3206_1-32H.mxd	
Coordinate System: NAD 1927 State Plane Kansas South FIPS: 1502	