


15.35-19156-0000

Give All Information Completely
Make Required Affidavit
Mail or Deliver Report to:
Conservation Division
State Corporation Commission
211 No. Broadway
Wichita, Kansas

WELL PLUGGING RECORD

NESS County, Sec. 4 Twp. 20S Rge. 24W (E) (W)

Location as "NE/CNW/SW" or footage from lines C NW SE
Lease Owner JENNINGS & CLOGG
Lease Name LUNDY Well No. 1
Office Address 662 - 1st NATIONAL BANK BLDG., OKLA. CITY, OKLA.
Character of Well (completed as Oil, Gas or Dry Hole) DRY HOLE
Date well completed DECEMBER 12, 1962
Application for plugging filed DECEMBER 13, 1962
Application for plugging approved DECEMBER 13, 1962
Plugging commenced DECEMBER 13, 1962
Plugging completed DECEMBER 13, 1962
Reason for abandonment of well or producing formation DRY HOLE

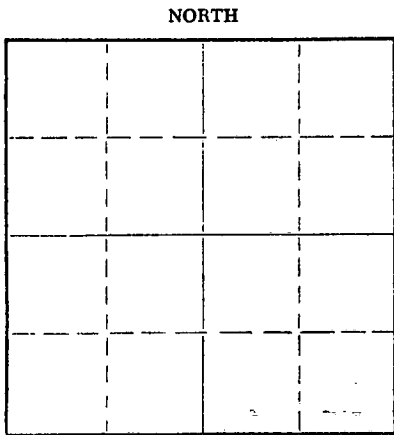

Locate well correctly on above Section Plat

If a producing well is abandoned, date of last production _____ 19____
Was permission obtained from the Conservation Division or its agents before plugging was commenced? YES

Name of Conservation Agent who supervised plugging of this well MR. ELDON PETTY, HAYS, KANSAS
Producing formation _____ Depth to top _____ Bottom _____ Total Depth of Well 4501 Feet
Show depth and thickness of all water, oil and gas formations.

OIL, GAS OR WATER RECORDS

CASING RECORD

FORMATION	CONTENT	FROM	TO	SIZE	PUT IN	PULLED OUT
<u>SURF. SOIL, CLAY & SHALE</u>	<u>SURFACE CSG.</u>	<u>-0-</u>	<u>311'</u>	<u>8-5/8"</u>	<u>311'</u>	<u>NONE</u>

Describe in detail the manner in which the well was plugged, indicating where the mud fluid was placed and the method or methods used in introducing it into the hole. If cement or other plugs were used, state the character of same and depth placed, from _____ feet to _____ feet for each plug set.

PLUGGED: Filled hole with heavy mud 4501' up to 500', 1/4 sk. hulls, Halliburton Plug, 20 sx. cement through drill pipe.
Filled hole with heavy mud up to 300', 1/4 sk. hulls, Halliburton Plug, 20 sx. cement through drill pipe.
Filled hole with heavy mud up to 40', 1/4 sk. hulls, Halliburton Plug, 10 sx. cement to cellar -0-.

Job completed 4:30 p.m. 12-13-62.

RECEIVED
STATE CORPORATION COMMISSION

DEC 19 1962

CONSERVATION DIVISION
WICHITA, KANSAS

(If additional description is necessary, use BACK of this sheet)

Name of Plugging Contractor SIERRA PETROLEUM CO., INC.
Address 208 PETROLEUM BUILDING, WICHITA, KANSAS

STATE OF KANSAS COUNTY OF RUSSELL, ss.
C. T. HONAKER, DRILLING SUPERINTENDENT

(employee of owner) or (owner or operator) of the above-described well, being first duly sworn on oath, says: That I have knowledge of the facts, statements, and matters herein contained and the log of the above-described well as filed and that the same are true and correct. So help me God.

(Signature) C. T. Honaker C. T. HONAKER, DRLG. SUPT.

BOX 232, RUSSELL, KANSAS
(Address)

SUBSCRIBED AND SWORN to before me this 17TH day of DECEMBER, 1962

Notary Public.

My commission expires 10-17-63



15-135-19156-0000

JENNINGS & CLOGG - Operator

SIERRA PETROLEUM CO., INC. - Contractor

LUNDY #1
C NW SE
Sec. 4-20S-24W
Ness County, Kansas

T. D.: 4501'
Elev.: 2339' G.L.

Commenced: 12-1-62
Completed: 12-12-62

Casing:

8-5/8" Set at 311'

Cement:

with 217 sx. Sunset

FORMATION

DEPTH

Surface Soil & Clay	30
Shale	970
Anhydrite	995
Shale & Shells	1090
Dakota Sand	1280
Shale & Shells	1340
Red Bed & Shale	1600
Shale & Shells	1720
Red Bed, Shale & Sand	2175
Shale & Lime	2535
Lime	2615
Lime & Shale	3745
Lime	3835
Lime & Chalk	3935
Lime	4405
Lime & Chert	4425
Lime	4501

RECEIVED
STATE CORPORATION COMMISSION

DEC 19 1962

CONSERVATION DIVISION
Wichita, Kansas

STATE OF KANSAS)
) ss:
COUNTY OF RUSSELL)

I hereby certify that the above information is true and correct to the best of my knowledge.

C. T. Honaker
Drilling Superintendent

Subscribed and sworn to before me this 17th day of December, 1962.

Jerome D. [Signature]
Notary Public

My commission expires: 10-17-63

