


15-135-19158-0000

WELL PLUGGING RECORD

Give All Information Completely  
Make Required Affidavit  
Mail or Deliver Report to:  
Conservation Division  
State Corporation Commission  
211 No. Broadway  
Wichita, Kansas

NORTH

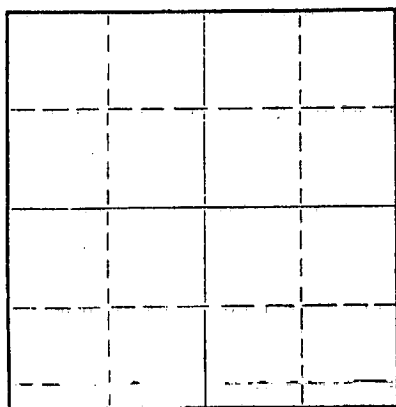

Locate well correctly on above  
Section Plat

Ness County. Sec. 32 Twp. 20 Rge. 24 (E) (W) X  
Location as "NE/CNW&SW" or footage from lines. S NE NE  
Lease Owner Mull Drilling Company, Inc.  
Lease Name McNair Well No. 1  
Office Address 1625 Wichita Plaza Building Wichita, Kansas  
Character of Well (completed as Oil, Gas or Dry Hole)  
Date well completed 19\_\_\_\_  
Application for plugging filed 2-3-61 19\_\_\_\_  
Application for plugging approved 2-11-61 19\_\_\_\_  
Plugging commenced 2-11-61 19\_\_\_\_  
Plugging completed 2-6-61 19\_\_\_\_  
Reason for abandonment of well or producing formation Dry

If a producing well is abandoned, date of last production 19\_\_\_\_  
Was permission obtained from the Conservation Division or its agents before plugging was commenced? Yes

Name of Conservation Agent who supervised plugging of this well Eldon Petty  
Producing formation \_\_\_\_\_ Depth to top \_\_\_\_\_ Bottom \_\_\_\_\_ Total Depth of Well 11150 Feet  
Show depth and thickness of all water, oil and gas formations.

OIL, GAS OR WATER RECORDS

CASING RECORD

FORMATION	CONTENT	FROM	TO	SIZE	PUT IN	PULLED OUT
				8 5/8	250	None
				1 1/2	None	3759

Describe in detail the manner in which the well was plugged, indicating where the mud fluid was placed and the method or methods used in introducing it into the hole. If cement or other plugs were used, state the character of same and depth placed, from \_\_\_\_\_ feet to \_\_\_\_\_ feet for each plug set.

Cleaning out cellar. Measuring in T.D. Sanded to 1370' and 3 sacks of cement. Rigging up jacks.

Shot pipe at 3732'. Working pipe. Pulling pipe.

Pulling pipe. Circulating mud. Spotted 50 sacks of cement.

REC'D  
02-04-61

(If additional description is necessary, use BACK of this sheet)

Name of Plugging Contractor Forbes Casing Pulling, Inc.  
Address P. O. Box 221 Great Bend, Kansas

STATE OF Kansas, COUNTY OF Barton, ss.  
J. O. Forbes (employee of owner) or (owner or operator) of the above-described well, being first duly sworn on oath, says: That I have knowledge of the facts, statements, and matters herein contained and the log of the above-described well as filed and that the same are true and correct. (So help me God.)

(Signature) J. O. Forbes  
P. O. Box 221 Great Bend, Kansas  
(Address)

SUBSCRIBED AND SWORN TO before me this 7 day of February, 1961

(Signature)  
Notary Public.

My commission expires May 27, 1961

R O T A R Y   D R I L L E R ' S   L O G

COMPANY: Mull Drilling Co., Inc. ROTARY DRILLING COMMENCED: 8-16-63  
Wichita, Kansas

CONTRACTOR: Mull Drilling Co., Inc. ROTARY DRILLING COMPLETED: 8-28-63  
Wichita, Kansas

CASING RECORD: Set 313' of 8 5/8" Surf. Csg.w/175 sx. LOCATION: #1 MacNair  
Set 4449' of 4 1/2" Csg. C NE NE 32-20S-24W  
x w/125 Sx. Ness County, Kansas

313'	Blue Shale
370'	Shale
1575'	Sandy Shale
1615'	Anhydrite
1770'	Shale
2105'	Shale & Lime
2590'	Shale
4225'	Lime & Shale
4333'	Lime
4382'	Lime w/shale
4390'	Conglomerate
4405'	Conglomerate Mississippi
4450'	Mississippi & Total Depth

**RECEIVED**  
STATE CORPORATION COMMISSION

FEB 11 1964

CONSERVATION DIVISION  
Wichita, Kansas

I hereby certify that this is a true and correct copy of the above log to the best of my knowledge.

MULL DRILLING COMPANY, INC.

*Joseph B. Brungardt, Jr.*  
Joseph B. Brungardt, Jr.

STATE OF KANSAS )  
                          ) SS  
COUNTY OF SEDGWICK)

Subscribed and sworn before me this 9th day of September, 1963.

*Lola L. Foster*  
Lola L. Foster, Notary Public

My commission expires April 17, 1966.

