


Give All Information Completely
Make Required Affidavit
Mail or Deliver Report to:
Conservation Division
State Corporation Commission
212 No. Market
Wichita, Kansas

WELL PLUGGING RECORD

Ness County. Sec. 19 Twp. 20 Rge. 24W (E) (W)
Location as "NE/CNW/SW" or footage from lines W/2 NW SE
Lease Owner Osage Oil & Gas
Lease Name Borden Well No. 1
Office Address 546 Petroleum Building, Wichita, Kansas
Character of Well (completed as Oil, Gas or Dry Hole) D & A
Date well completed April 9, 1959 19
Application for plugging filed 19
Application for plugging approved 19
Plugging commenced April 9, 1959 19
Plugging completed April 9, 1959 19
Reason for abandonment of well or producing formation

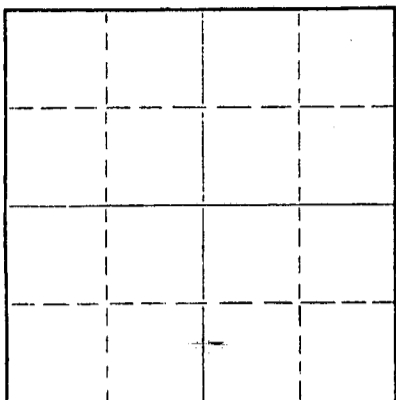

Locate well correctly on above
Section Plat

If a producing well is abandoned, date of last production 19
Was permission obtained from the Conservation Division or its agents before plugging was commenced? Yes

Name of Conservation Agent who supervised plugging of this well Gilbert Leiker
Producing formation Depth to top Bottom Total Depth of Well 4515 Feet
Show depth and thickness of all water, oil and gas formations.

OIL, GAS OR WATER RECORDS

CASING RECORD

FORMATION	CONTENT	FROM	TO	SIZE	PUT IN	PULLED OUT

Describe in detail the manner in which the well was plugged, indicating where the mud fluid was placed and the method or methods used in introducing it into the hole. If cement or other plugs were used, state the character of same and depth placed, from feet to feet for each plug set.

T.D. 4515' 8 5/8" pipe set at 245
Gunned pits circulated hole with heavy mud, set cementing plug at 600', and displaced 20 sacks cement through drill pipe, heavy mud to 240' set cementing plug and displaced 15 sacks cement, heavy mud to 40', set and tied cementing plug in place and displaced 10 sacks cement. cementing to base of cellar.

RECEIVED
STATE CORPORATION COMMISSION

MAY 13 1966

(If additional description is necessary, use BACK of this sheet)

Name of Plugging Contractor Leben Drilling Company
Address 905 Central Building, Wichita, Kansas

STATE OF Kansas COUNTY OF Sedgewick, ss.
(employee of owner) or (owner or operator) of the above-described

well, being first duly sworn on oath, says: That I have knowledge of the facts, statements, and matters herein contained and the log of the above-described well as filed and that the same are true and correct. So help me God.

(Signature) Donald F. Moore

(Address) May 13, 1966
Sebastian S. Greuter
Notary Public.

