


STATE OF KANSAS
STATE CORPORATION COMMISSION

WELL PLUGGING RECORD

Give All Information Completely
Make Required Affidavit
Mail or Deliver Report to
Conservation Division
State Corporation Comm.
245 North Water
Wichita, KS 67202

Ness County. Sec. 20 Twp. 20S Rge. 24 SE
Location as "NE/CNW SW 1/2" or footage from lines _____

NW NE SW
Lease Owner Ewer Petroleum Company
Lease Name Lehner Well No. #1
Office Address KSB&T Bldg. - Suite 816, Wichita, Ks. 6720
Character of Well (Completed as Oil, Gas or Dry Hole) _____

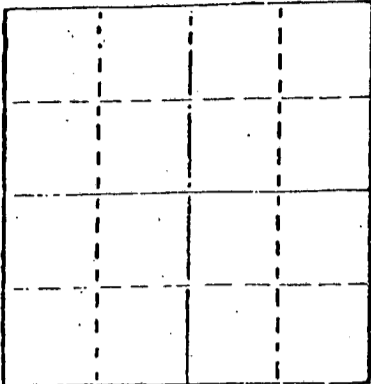

Locate well correctly on above Section Plat

Dry Hole
Date Well completed 8-12-81 19
Application for plugging filed 8-12-81 19
Application for plugging approved 8-12-81 19
Plugging commenced 8-12-81 19
Plugging completed 8-12-81 19

Reason for abandonment of well or producing formation _____
Commercial quantities of oil not found
If a producing well is abandoned, date of last production _____ 19

Was permission obtained from the Conservation Division or its agents before plugging was commenced? Yes

Name of Conservation Agent who supervised plugging of this well Marion Schmidt
Producing formation _____ Depth to top _____ Bottom _____ Total Depth of Well 446
Show depth and thickness of all water, oil and gas formations.

OIL, GAS OR WATER RECORDS

CASING RECORD

FORMATION	CONTENT	FROM	TO	SIZE	PUT IN	PULLED OUT
				8 5/8"	289'	None

Describe in detail the manner in which the well was plugged, indicating where the mud fl was placed and the method or methods used in introducing it into the hold. If cement or of plugs were used, state the character of same and depth placed, from _____ feet to _____ feet for each plug set.

Plug @ 920' w/70 sx.
Plug @ 270' w/40 sx.
Plug @ 40' w/10 sx.
Rat Hole 5 sx.

RECEIVED
STATE CORPORATION COMMISSION

OCT 16 1981

(If additional description is necessary, use BACK of this sheet)

Name of Plugging Contractor Rains & Williamson Oil Co., Inc. CONSERVATION DIVISION
Wichita, Kansas

STATE OF Kansas COUNTY OF Sedgwick, ss.

Wilson Rains, President of Rains & Williamson Oil Co., Inc. (employee of owner) or (owner or operat of the above-described well, being first duly sworn on oath, says: That I have knowledge of the facts, statements, and matters herein contained and the log of the above-described well as filed and that the same are true and correct. So help me God.

(Signature) Wilson Rains

435 Page Court, 220 W. Douglas, Wichita, Ks. 672
(Address)

SUBSCRIBED AND SWORN TO before me this 18 day of August, 1981

My commission expires _____

10-4-83

Juanita M. Green
Notary Public.



DRILLER'S LOG

COMPANY: Euwer Petroleum Company

SEC. 20 T. 20S R. 24W

WELL NAME: Lehner #1

LOC. NW NE SW

COUNTY: Ness

RIG NO. #2

TOTAL DEPTH 4465'

ELEVATION

COMMENCED: 8-1-81

COMPLETED: 8-12-81

CONTRACTOR: Rains & Williamson Oil Co., Inc.

CASING RECORD:

SURFACE: 8 5/8" @ 289' w/175 sx. 50/50 poz., 2% gel, 3% cc.

PRODUCTION: D&A

LOG

(Figures Indicate Bottom of Formations)

Sand	1345
Shale	1687
Shale & Lime	2786
Lime & Shale	3148
Shale & Lime	3229
Lime & Shale	3673
Lime, Shale & Sand	3834
Lime & Shale	4152
Lime	4360
Shale & Lime	4465
<u>ROTARY TOTAL DEPTH</u>	<u>4465</u>

STATE OF Kansas)

COUNTY OF Sedgwick)

SS:

RECEIVED
STATE CORPORATION COMMISSIONER

I, Wilson Rains, President of Rains & Williamson Oil Co., Inc. **OCT 16 1981**

upon oath state that the above and foregoing is a true and correct copy of the log of the

Lehner #1 well.

Wilson Rains
Wilson Rains

CONSERVATION DIVISION
Wichita, Kansas

Subscribed and sworn to before me this 18 day of August, 1981.

My Appointment Expires:

10-4-83

Juanita M. Green
Juanita M. Green

