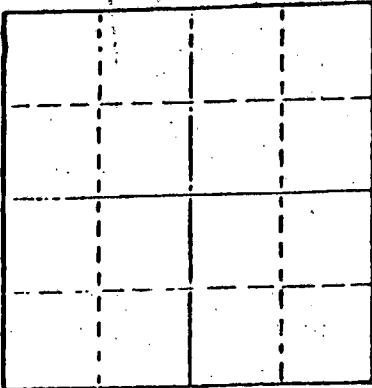


STATE OF KANSAS
STATE CORPORATION COMMISSION

WELL PLUGGING RECORD

Give All Information Completely
Make Required Affidavit
Mail or Deliver Report to
Conservation Division
State Corporation Comm.
245 North Water
Wichita, KS 67202

Locate well correctly on above
Section Plot

Ness County. Sec. 25 Twp. 20S Rge. 24 E/W
Location as "NE/CNW/SW" or footage from lines
SESW 660' FSL, 1980' FWL

Lease Owner Voyager Petroleum, INC.
Lease Name Eynard Well No. 25-14
Office Address 800 Petroleum Bldg. Denver, Colorado 80202
Character of Well (Completed as Oil, Gas or Dry Hole)
Dry Hole

Date Well completed 19
Application for plugging filed 19
Application for plugging approved 19
Plugging commenced 5/4/81 19
Plugging completed 5/5/81 19
Reason for abandonment of well or producing formation
No evidence of oil production

If a producing well is abandoned, date of last production
19

Was permission obtained from the Conservation Division or
its agents before plugging was commenced? Yes

Name of Conservation Agent who supervised plugging of this well Gilbert Balthazar
Producing formation Depth to top Bottom Total Depth of Well 4500
Show depth and thickness of all water, oil and gas formations.

OIL, GAS OR WATER RECORDS

CASING RECORD

FORMATION	CONTENT	FROM	TO	SIZE	PUT IN	PULLED OUT
None						

Describe in detail the manner in which the well was plugged, indicating where the mud fluid
was placed and the method or methods used in introducing it into the hold. If cement or other
plugs were used, state the character of same and depth placed, from feet to
feet for each plug set.

65 sacks at 850'

30 sacks at 300'

10 sacks in solid bridge plug at 40'

5 sacks in rathole

5 sacks in mousehole

(If additional description is necessary, use BACK of this sheet)

Name of Plugging Contractor Sun Oilwell

STATE OF Colorado COUNTY OF Denver, ss.
(employee of owner) or (owner or operator)
of the above-described well, being first duly sworn on oath, says: That I have knowledge of
the facts, statements, and matters herein contained and the log of the above-described well
as filed and that the same are true and correct. So help me God.

(Signature)

800 Petroleum Bldg. Denver, Colorado 80202

(Address)

SUBSCRIBED AND SWORN TO before me this 5th day of June

My commission expires August 15, 1984

RECEIVED

STATE CORPORATION COMMISSION

JUN 17 1981

CONSERVATION DIVISION
Wichita, Kansas

15.35. 22009.0000

COMPANY VOYAGER PETROLEUMS, INC.

WELL EYNARD #25-14

FIELD

COUNTY NESS STATE KANSAS

Location

Sec. 25 Twp. 17S Rge. 27W

Other Services:

CPI
CML/PCU

Permanent Datum: GROUND LEVEL Elev. 2952

g Measured From K.B., 12 Ft. Above Perm. Datum

Elev.: K.B. 2964
D.R. 2962
G.L. 2952

g Measured From KELLY BUSHING

No. 5/3/81

Driller 4500

Logger 4505

Log Inter. 4504

Log Inter. SURE

Driller 8 5/8 @ 257

Logger 7 7/8

Log Inter. 7 7/8

Log Inter. 7 7/8

RECEIVED
STATE CORPORATION COMMISSION

JUN 17 1981

CONSERVATION DIVISION
Wichita, Kansas

Flow Line

Flow Line

One Minute Worked

4500

BLI

