

15-159-03832-0000


STATE OF KANSAS
STATE CORPORATION COMMISSION

Form CP-4

Give All Information Completely
Make Required Affidavit
Mail or Deliver Report to:
Conservation Division
State Corporation Commission
212 No. Market
Wichita, Kansas 67202

WELL PLUGGING RECORD

Rice County. Sec. 15 Twp. 19 Rge. (E) 9 (W)
Location as "NE/CNWxSWx" or footage from lines. SW NW SW
Lease Owner Kaiser-Francis
Lease Name Cramm Well No. 5
Office Address 4120 E. 51st Street, Tulsa, Oklahoma 74135
Character of Well (completed as Oil, Gas or Dry Hole) oil
Date well completed _____ 19____
Application for plugging filed December 8 19 70
Application for plugging approved _____ 19____
Plugging commenced December 9 19 70
Plugging completed December 10 19 70
Reason for abandonment of well or producing formation depleted

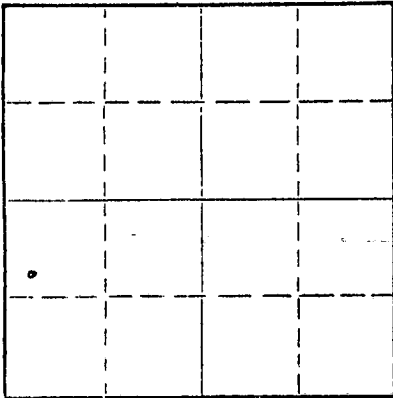

Locate well correctly on above
Section Plat

If a producing well is abandoned, date of last production _____ 19____
Was permission obtained from the Conservation Division or its agents before plugging was commenced? yes

Name of Conservation Agent who supervised plugging of this well. Gilbert Toman
Producing formation _____ Depth to top _____ Bottom _____ Total Depth of Well 3222 Feet
Show depth and thickness of all water, oil and gas formations.

OIL, GAS OR WATER RECORDS

CASING RECORD

FORMATION	CONTENT	FROM	TO	SIZE	PUT IN	PULLED OUT
		0	197'	8 5/8"	197'	none
		0	3204'	5 1/2"	3204'	556.21

Describe in detail the manner in which the well was plugged, indicating where the mud fluid was placed and the method or methods used in introducing it into the hole. If cement or other plugs were used, state the character of same and depth placed, from _____ feet to _____ feet for each plug set.

Set plug at 2950'. Sanded back to 2900' and dumped 5 sacks of cement.

Set 20' rock bridge at 220'. Plugged well with 45 sacks of cement.

RECEIVED
STATE CORPORATION COMMISSION
DEC 16 1970
CONSERVATION DIVISION
Wichita, Kansas

Name of Plugging Contractor PIPE PULLERS, INC.
Address Box 486, Ellinwood, Kansas

STATE OF KANSAS, COUNTY OF BARTON, ss.
Evelyn Roth (employee of owner) or (owner or operator) of the above-described well, being first duly sworn on oath, says: That I have knowledge of the facts, statements, and matters herein contained and the log of the above-described well as filed and that the same are true and correct. So help me God.

(Signature) Evelyn Roth
Ellinwood, Kansas
(Address)

SUBSCRIBED AND SWORN to before me this 15th day of December, 19 70

My commission expires Feb. 10, 1971
Serge A. Meyer Notary Public.

15-159-03832-0000

Bishop Oil Company
Contractor: Sharon Drilling Co., Inc.
Commenced: September 14, 1943
Completed: October 11, 1943
Total Depth: 3222'

No. 5 Cramm C SW NW S 15-19-9w, Rice County, Kansas

RECEIVED
STATE CORPORATION COMMISSION
DEC 10 1970
CONSERVATION DIVISION
Wichita, Kansas

Casing Record

197' of 8-5/8 surface casing. Cemented with 125 sacks cement.
3204' of 5 1/2 O. D. casing. Cemented with 125 sacks cement.

El. 1698 D.E.
I.P. 180 B/D
500 gal. Acid + 1500 gal
at T.D.

LOG

Surface	0'	to 11'
Clay shale	150'	
Sand	168'	
Red rock shale	220'	
Red bed	465'	
Shale and shells	600'	
Red rock shale	760'	
Shale and shells	810'	
Salt and shale	1100'	
Shale and shells	1175'	
Lime shale	1425'	
Sand	1485'	
Lime	1615'	
Broken Lime	1700'	
Shale	1745'	
Broken lime	1900'	
Shale and shells	2060'	
Shale	2434'	
Lime	2810'	
Broken lime	2835'	
Shale	2863'	
Lime	3102'	
Lime and shale	3142'	
Lime	3148'	
Shale	3200'	
Arbuckle lime	3209'	R. T. D.
T. D.	3222'	

Geol. Tops

Topeka	2432
Heebner	2727-30
Brown lime	2837
Lansing	2862
Basal Kc.	3143
Chert Cong.	3191
Arb	3200
T.D.	3222

State of Kansas, County of Sedgwick, SS

I hereby certify that the foregoing log is, to the best of my knowledge and belief, true and correct.

Sharon Drilling Company, Inc.

BY: A. S. Cates

Subscribed and sworn to before me, a notary public in and for the State and County, aforesaid this 14th day of October, 1943.

Jessie M. Hunt
Notary Public

My Commission Expires: Sept 16 - 1944