

15-135-20313-0000

STATE OF KANSAS
STATE CORPORATION COMMISSION

Form CP-4

Give All Information Completely
Make Required Affidavit
Mail or Deliver Report to:
Conservation Division
State Corporation Commission
212 No. Market
Wichita, Kansas

WELL PLUGGING RECORD

Ness County, Sec. 13 Twp. 20S Rge. 23W (E) (W)

Location as "NE/CNW/SW" or footage from lines C NW NW

Lease Owner Palomino Petroleum

Lease Name Maranville "B" Well No. 3

Office Address 304 Insurance Bldg., Wichita, Kansas 67202

Character of Well (completed as Oil, Gas or Dry Hole) Dry Hole

Date well completed January 23 1970

Application for plugging filed January 23 1970

Application for plugging approved January 23 1970


Plugging commenced January 23 1970

Plugging completed January 23 1970

Reason for abandonment of well or producing formation Dry Hole

If a producing well is abandoned, date of last production 19

Was permission obtained from the Conservation Division or its agents before plugging was commenced? Yes

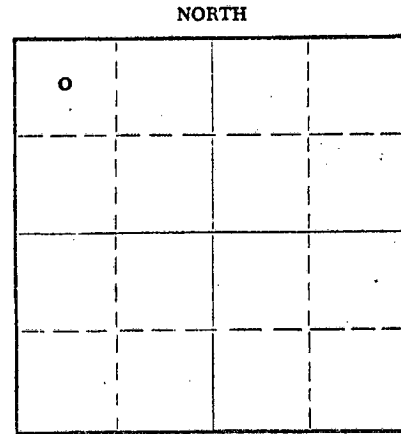

Locate well correctly on above Section Plat

Name of Conservation Agent who supervised plugging of this well Leo F. Massey, Hays, Kansas

Producing formation Depth to top Bottom Total Depth of Well 4348' Feet

Show depth and thickness of all water, oil and gas formations.

OIL, GAS OR WATER RECORDS

CASING RECORD

FORMATION	CONTENT	FROM	TO	SIZE	PUT IN	PULLED OUT
		0	290'	8 5/8"	290'	None

Describe in detail the manner in which the well was plugged, indicating where the mud fluid was placed and the method or methods used in introducing it into the hole. If cement or other plugs were used, state the character of same and depth placed, from feet to feet for each plug set.

Plug:

600'/70 sacks cement

270'/20 sacks cement

good bridge / 40'/10 sacks cement

RECEIVED
STATE CORPORATION COMMISSION
JAN 30 1970
CONSERVATION DIVISION
Wichita, Kansas

(If additional description is necessary, use BACK of this sheet)

Name of Plugging Contractor Hellar Drilling Company, Inc.

Address 339 Union Center Bldg., Wichita, Kansas 67202

STATE OF Kansas, COUNTY OF Sedgwick, ss.

I, D. L. Hellar, President of Hellar Drig. Co. (Employee of owner) or (owner or operator) of the above-described well being first duly sworn on oath, says: That I have knowledge of the facts, statements, and matters herein contained and the log of the above-described well as filed and that the same are true and correct. So help me God.

(Signature) D. L. Hellar, President


339 Union Center Bldg., Wichita, Kansas 67202

(Address)

SUBSCRIBED AND SWORN to before me this 28th day of January, 1970

My commission expires March 25, 1972

Catherine Darcey Notary Public

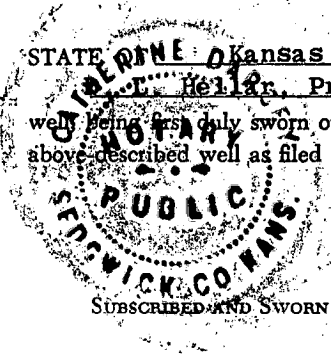

DRILLER'S LOG

COMPANY: Palomino Petroleum, 304 Insurance Bldg., Wichita, Kansas 67202

CONTRACTOR: Hellar Drilling Company, Inc., Wichita, Kansas 67202

LEASE: #3 Maranville "B"

LOCATION: C NW NW 13-20S-23W, Ness County, Kansas

COMMENCED: January 12, 1970

COMPLETED: January 23, 1970

CASING: Set 8 5/8" Surface Casing @ 290'/165 sacks cement

0-60	Surface soil & shale
60-150	Shale & Rock
150-520	Shale
520-1307	Shale - Shells- Red Bed & Sand
1307-1350	Red Bed
1350-1412	Shale
1412-1447	Anhydrite
1447-1840	Shale & Shells
1840-2185	Salt Section & Shells
2185-2337	Shale & Shells
2337-2470	Lime
2470-3660	Lime & Shale
3660-3689	Lime
3689-3957	Lime (K.C.)
3957-4000	Lime
4000-4164	Lime & Shale
4164-4230	Lime
4230-4250	Lime & Shale (Ft. Scott)
4250-4330	Lime
4330-4338	Miss.
4338-4343	Chert
4343-4348	Miss.
4348	Rotary Total Depth

RECEIVED
STATE CORPORATION COMMISSION
JAN 30 1970
CONSERVATION DIVISION
Wichita, Kansas

D & A

STATE OF KANSAS)
) SS
COUNTY OF SEDGWICK)

I, D. L. Hellar, do hereby certify that the above and foregoing is a true and correct copy of the log of the #3 Maranville "B", located in C NW NW 13-20S-23W, Ness County, Kansas, as reflected by the files of the Hellar Drilling Company, Inc.

HELLAR DRILLING COMPANY, INC.

By D. L. Hellar
President - D. L. Hellar

Subscribed and sworn to before me, a Notary Public, in and for Sedgwick County, Kansas, this _____ day of January, 1970.

My Commission Expires:
March 25, 1972.

Catherine Darcey
Notary Public - Catherine Darcey

