


Give All Information Completely
Make Required Affidavit
Mail or Deliver Report to:
Conservation Division
State Corporation Commission
211 No. Broadway
Wichita, Kansas

WELL PLUGGING RECORD

Ness County. Sec. 11 Twp. 20S Rge. 21W (E) (W)

Location as "NE/CNW/SW" or footage from lines 6 SE NW
Lease Owner Mull Drilling Co. Inc.
Lease Name Walter Rothe Well No. 1
Office Address 1625 Plaza Building Wichita, Ks.
Character of Well (completed as Oil, Gas or Dry Hole) Dry
Date well completed 9-8-63 19
Application for plugging filed 9-8-63 19
Application for plugging approved 9-8-63 19
Plugging commenced 9-8-63 19
Plugging completed 9-8-63 19
Reason for abandonment of well or producing formation Non Productive.

If a producing well is abandoned, date of last production None 19
Was permission obtained from the Conservation Division or its agents before plugging was commenced? Yes

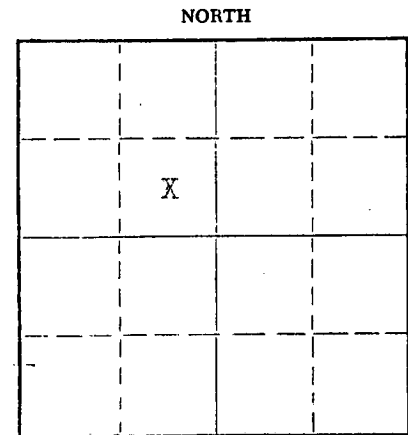

Locate well correctly on above
Section Plat

Name of Conservation Agent who supervised plugging of this well Mr. Petty Hays, Kansas
Producing formation Depth to top Bottom Total Depth of Well 1179 Feet
Show depth and thickness of all water, oil and gas formations.

OIL, GAS OR WATER RECORDS

CASING RECORD

| FORMATION | CONTENT | FROM | TO | SIZE | PUT IN | PULLED OUT |
|-----------|---------|------|----|------|--------|------------|
| | | | | | | |
| | | | | | | |
Describe in detail the manner in which the well was plugged, indicating where the mud fluid was placed and the method or methods used in introducing it into the hole. If cement or other plugs were used, state the character of same and depth placed, from feet to feet for each plug set.

Plugged through drill pipe with a plug put at 540' with 20 sacks cement, a plug put at 250' with 20 sacks cement, and a plug put at 40' and 10 sacks cement.

RECEIVED
STATE CORPORATION COMMISSION

SEP 17 1963

CONSERVATION DIVISION
Wichita, Kansas

(If additional description is necessary, use BACK of this sheet)
Name of Plugging Contractor Globe Cementing Cp.
Address Great Bend, Kansas

STATE OF KANSAS, COUNTY OF SEDGWICK, ss.
Joseph O. Butts (employee of owner) or (owner or operator) of the above-described well, being first duly sworn on oath, says: That I have knowledge of the facts, statements, and matters herein contained and the log of the above-described well as filed and that the same are true and correct. So help me God.

(Signature) Joseph O. Butts
Wichita, Kansas


(Address)

SUBSCRIBED AND SWORN to before me this 16th day of September, 1963

Bettie H. Salter

Notary Public.

My commission expires October 16, 1965

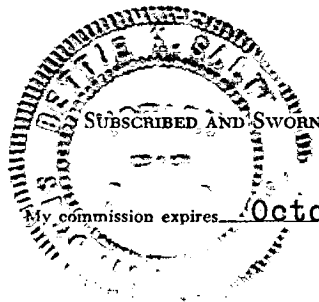

R O T A R Y D R I L L E R ' S L O G

COMPANY: Mull Drilling Co., Inc. ROTARY DRILLING COMMENCED: 8/29/63
Wichita, Kansas

CONTRACTOR: Mull Drilling Co., Inc. ROTARY DRILLING COMPLETED: 9/8/63
Wichita, Kansas

CASING RECORD: Set 244' of 8 5/8" Surf. LOCATION: #1 Rothe
csg. w/ 165 Sk. C SE NW 11-20S-24W
Ness County, Kansas

Figures indicate bottom of formation-measurements from top of Rotary Bushing.)

| | |
|-------|---------------------------|
| 550' | Blue Shale |
| 1050' | Blue Shale w/Sand |
| 1280' | Sand |
| 1580' | Shale w/Sand |
| 1620' | Anhydrite |
| 2400' | Shale |
| 3032' | Lime w/Shale |
| 3226' | Sandy Lime w/Shale |
| 3335' | Lime w/Shale |
| 3530' | Sandy Lime & Shale |
| 4255' | Lime w/Shale |
| 4325' | Lime |
| 4385' | Lime w/Shale |
| 4420' | Chert & Lime |
| 4430' | Conglomerate |
| 4440' | Mississippi |
| 4450' | Mississippi Lime & Chert |
| 4479' | Mississippi & Total Depth |

RECEIVED
STATE CORPORATION COMMISSION

SEP 17 1963

CONSERVATION DIVISION
Wichita, Kansas

I hereby certify that this is a true and correct copy of the above log to the best of my knowledge.



MULL DRILLING COMPANY, INC.

Joseph B. Brungardt, Jr.
Joseph B. Brungardt, Jr.

STATE OF KANSAS)
COUNTY OF SEDGWICK)

Subscribed and sworn before me this 16th day of September, 1963.

Lola L. Foster
Lola L. Foster, Notary Public

My commission expires April 17, 1966.