

15-071-20162-0000

STATE OF KANSAS  
STATE CORPORATION COMMISSION


Form CP-4

Give All Information Completely  
Make Required Affidavit  
Mail or Deliver Report to:  
Conservation Division  
State Corporation Commission

WELL PLUGGING RECORD

P. O. Box 17027  
Wichita, Kansas 67217  
NORTH

Greeley County, Sec. 36 Twp. 17S. Rge. 41 (X) (W)  
Location as "NE/CNW/SW" or footage from lines C SW/4  
Lease Owner R. C. Banks  
Lease Name Harris Well No. 1  
Office Address Box 242; Midland, TX 79701  
Character of Well (completed as Oil, Gas or Dry Hole) Dry Hole  
Date well completed 10/3/78 19  
Application for plugging filed 1/12/79 19  
Application for plugging approved 19  
Plugging commenced 10/2/78 19  
Plugging completed 10/3/78 19  
Reason for abandonment of well or producing formation Non-commercial

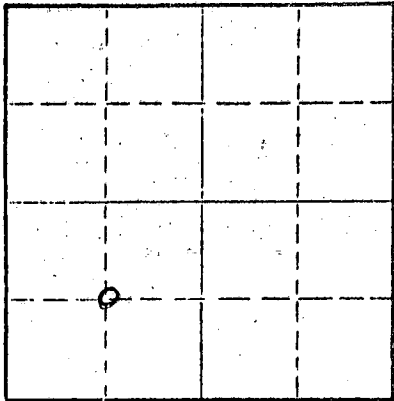

Locate well correctly on above  
Section Plat

If a producing well is abandoned, date of last production Non-productive 19  
Was permission obtained from the Conservation Division or its agents before plugging was commenced? Yes

Name of Conservation Agent who supervised plugging of this well Clarence Thomas, Jr.  
Producing formation Chase Depth to top 2927 Bottom 3050 Total Depth of Well 3050 Feet  
Show depth and thickness of all water, oil and gas formations.

OIL, GAS OR WATER RECORDS

CASING RECORD

FORMATION	CONTENT	FROM	TO	SIZE	PUT IN	PULLED OUT
Upper Winfield	Non-Comm.	2927	2940	8-5/8"	241'	None
Lower Winfield	" "	2940	2984			
Upper Ft. Riley	" "	2984	3038			
Lower Ft. Riley	" "	3038	3050			

Describe in detail the manner in which the well was plugged, indicating where the mud fluid was placed and the method or methods used in introducing it into the hole. If cement or other plugs were used, state the character of same and depth placed, from \_\_\_\_\_ feet to \_\_\_\_\_ feet for each plug set.

Heavy mud from 3050 to 240'  
35 sx cement from 240' to 110'  
Heavy mud from 110' to 40'  
10 sx cement 40' to 3'  
8-5/8" casing cut off 3' below Gl.  
5 sx cement in rat. hole.

RECEIVED  
STATE CORPORATION COMMISSION  
JAN 17 1979  
CONSERVATION DIVISION  
Wichita, Kansas

(If additional description is necessary, use BACK of this sheet)

Name of Plugging Contractor Lakin Drilling & Halliburton Services  
Address Lakin, Kansas - Box 69; Liberal, Kansas 67901

STATE OF KANSAS, COUNTY OF SEWARD, ss.  
R. L. Higginbottom, Agent (employee of owner) or (owner or operator) of the above-described well, being first duly sworn on oath, says: That I have knowledge of the facts, statements, and matters herein contained and the log of the above-described well as filed and that the same are true and correct. So help me God.

(Signature) *R. L. Higginbottom*

P. O. Box 6; Liberal, Ks. 67901 (Address)

SUBSCRIBED AND SWORN TO before me this 16th day of January, 19 79

My commission expires

A. J. PARNELL  
Seward County, Kansas  
My Appt. Exp. 7-7-81

Notary Public.