


STATE OF KANSAS
STATE CORPORATION COMMISSION

WELL PLUGGING RECORD

Give All Information Completely
Make Required Affidavit
Mail or Deliver Report to
Conservation Division
State Corporation Comm.
245 North Water
Wichita, KS 67202

Ness County, Sec. 30 Twp. 20S Rge. 23W E/W
Location as "NE/CNW}SW}" or footage from lines C NE NW SW

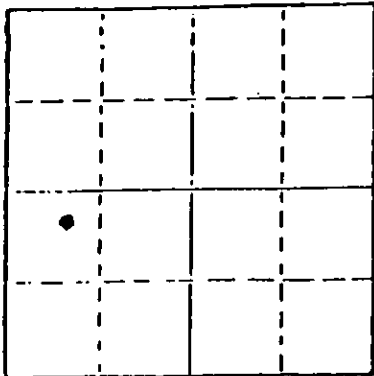

Locate well correctly on above
Section Plat

Lease Owner Statex Petroleum, Inc.
Lease Name Stum Well No. 1-30
Office Address P.O. Box 152011, Irving, Texas 75015
Character of Well (Completed as Oil, Gas or Dry Hole) _____
(Originally Oil Well) Present P&A _____
Date Well completed November 13 1982
Application for plugging filed Verbal 19____
Application for plugging approved _____ 19____
Plugging commenced February 10 1985
Plugging completed February 11 1985
Reason for abandonment of well or producing formation _____
Depleted
If a producing well is abandoned, date of last production _____
August 23 1983

Was permission obtained from the Conservation Division or
its agents before plugging was commenced? Yes

Name of Conservation Agent who supervised plugging of this well Richard Lacy
Producing formation Mississippi Depth to top 4349 Bottom 4359 Total Depth of Well 4369
Show depth and thickness of all water, oil and gas formations.

OIL, GAS OR WATER RECORDS

CASING RECORD

FORMATION	CONTENT	FROM	TO	SIZE	PUT IN	PULLED OUT
Stone Corral	Dry	1473		8-5/8	496'	None
Base, Kansas City	Dry	4100		4-1/2	4363'	2350'
Ft. Scott Lime	DRY	4249'	4262'			
Mississippi Dolo	Oil	4349	4369'			

Describe in detail the manner in which the well was plugged, indicating where the mud fluid was placed and the method or methods used in introducing it into the hold. If cement or other plugs were used, state the character of same and depth placed, from _____ feet to _____ feet for each plug set. Sand back to 4300'. Dump 4 sxs cmt with dump bailer. Run free point and cut 4-1/2" csg off at 2350'. Pull 61 jts 4-1/2" csg. Plug w/2 sxs hulls, 15 sxs gel, 70 sxs 60-40 Pozmix w/2% gel + 3% CC, 10 sxs gel, 1 sx hulls. Rel 8-5/8" top plug. Pump 150 sxs 60-40 Pozmix + 2% gel, + 3% CC. Cut off 8-5/8" csg 3' below ground level and weld on I.D. plate.

(If additional description is necessary, use BACK of this sheet)

Name of Plugging Contractor Halliburton

STATE OF TEXAS COUNTY OF DALLAS, ss.
Bob Jackson (employee of owner) or (owner or operator)
of the above-described well, being first duly sworn on oath, says: That I have knowledge of the facts, statements, and matters herein contained and the log of the above-described well as filed and that the same are true and correct. So help me God.

(Signature) Bob Jackson
P.O. Box 152011, Irving, Texas 75015
(Address)

SUBSCRIBED AND SWORN TO before me this 23rd day of April, 1985

My commission expires 7-31-85

Theresa Lopez
Notary Public.
in and for the State of Texas

RECEIVED
STATE CORPORATION COMMISSION

APR 25 1985

CONSERVATION DIVISION
Wichita, Kansas

1905
153
01