

15.135-22361-0000

STATE OF KANSAS  
STATE CORPORATION COMMISSION  
200 Colorado Derby Bldg.  
Wichita, Kansas 67202

RECEIVED Form CP-4  
STATE CORPORATION COMMISSION Rev. 12-15-80


FEB 25 1983

CONSERVATION DIVISION  
Wichita, Kansas

WELL PLUGGING RECORD

Give All Information Completely  
Make Required Affidavit

COUNTY Ness SEC. 1 TWP. 20S RGE. 24W E/W  
Location as in quarters or footage from lines:  
S/2 SW SW 1-20S-24W

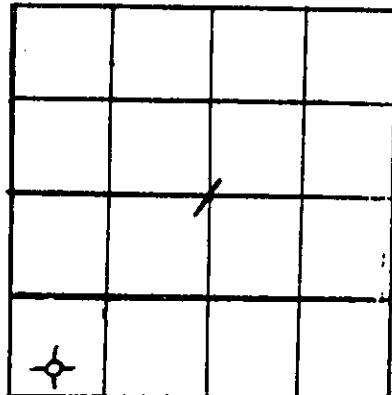

Locate Well  
correctly on above  
Section Platt.

Lease Owner Chief Drilling Co., Inc.  
Lease Name Petersille Well No. #1  
Office Address 905 Century Plaza Wichita, Ks. 67202  
Character of Well (Completed as Oil, Gas or Dry Hole): D.H.  
Date Well Completed 2-19-83  
Application for plugging filed 2-19-83  
Plugging commenced 2-19-83  
Plugging completed 2-19-83  
Reason for abandonment of well or producing formation \_\_\_\_\_

Was permission obtained from the Conservation Division or it's  
Agent's before plugging was commenced? yes

Name of Conservation Agent who supervised plugging of this well done by phone w/District #1  
Producing formation \_\_\_\_\_ Depth to top \_\_\_\_\_ bottom \_\_\_\_\_ T.D. \_\_\_\_\_

Show depth and thickness of all water, oil and gas formations.

OIL, GAS OR WATER RECORDS

Casing Record

Formation	Content	From	To	Size	Put in	Pulled Out
Surface	8 5/8	598' set	@ 607'	cem. w/300 sx.	60-40 pos mix.	38 c.c., 28 gel.

Describe in detail the manner in which the well was plugged, indicating where the mud fluid was placed and the method or methods used in introducing it into the hold. If cement or other plugs were used, state the character of same and depth placed, from \_\_\_\_\_ feet to \_\_\_\_\_ feet for each plug set.

Plugged w/50 sx., @ 1600', 50 sx. @ 630', 10 sx. & solid bridge plug @ 40', 10 sx. in rat hole, 10 sx. in mouse hole, State Pluggger District #1, started @ 12:30 a.m. Completed @ 4:00 a.m.

(If additional description is necessary, use BACK of this sheet)


Name of Plugging Contractor Warrior Drilling Co. #2

STATE OF Kansas COUNTY OF Sedgwick, ss.  
F.W. Shelton, Jr. (employee of owner) ~~of the~~ of the  
above-described well, being first duly sworn on oath, says: That I have knowledge of the  
facts, statements, and matters herein contained and the log of the above-described well as  
filed and that the same are true and correct. So help me God.

(Signature) F.W. Shelton, Jr.  
F.W. Shelton, Jr., Vice Pres.  
(Address)

SUBSCRIBED AND SWORN TO before me this 20 day of February, 19 83.

My Commission expires:

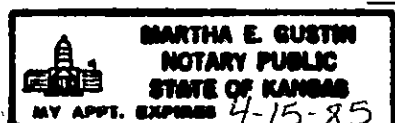

Martha E. Gustin  
Martha E. Gustin Notary Public.